

MISSISSIPPI DEPARTMENT OF NATURAL RESOURCES

Bureau of Land and Water Resources

Southport Mall

P.O. Box 10631

Jackson, Mississippi 39209

WATER WELL DRILLERS LOG

Pearl River
 2 2071
 11-5-81

11-5 1981 Bud Penton & Son P.R.
 date well completed firm name county well located

LANDOWNER: Eyes Smith
Salem MS.

description of formations encountered

from

to

gray shale	0	20
white sand	20	50
blue shale	50	160
gray sand	160	220
blue shale	220	300
blue sand	300	625

(mailing address)

WELL LOCATION:

sec. 9 T. 6 N. R. 16 E
6.25 miles E of Prejean
 (distance) (direction) (nearest town)

WELL PURPOSE: irrigation
 (home, irrigation, municipal, industrial)

WELL COMPLETION DATA:

- (1) diameter (inches) 4
- (2) total depth (feet) 625'
- (3) static water level (feet) 30 below top of ground.
- (4) casing PVC 615'
 (material) (depth)

(size) if telescope see back.

- (5) screen 10' 615'
 (length) (depth to top)

4 PVC
 (size) (material)

- (6) pump 5 130 min.
 (HP) (yield gpm)

idea
 (type power)

- (7) electric log (yes or no) _____

(organization running log) _____

- (8) how well bottom plugged yes
slip

DRILLERS REMARKS: _____


DEPT. OF NATURAL RESOURCES
 BUREAU OF LAND & WATER RESOURCES

NOV 9 - 1981

RECEIVED

If well telescopes please sketch and show depths.

GROUND LEVEL

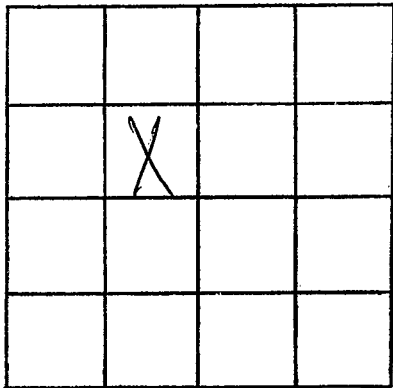

SECTION _____

Please indicate well location X.

ADDITIONAL INFORMATION

If more than one screen,
show locations of each on sketch.