

Pearl River
X 2073

MISSISSIPPI
 BOARD OF WATER COMMISSIONERS
 416 North State Street
 Jackson, Mississippi 39201

WATER WELL DRILLERS LOG

3-26 1982 Penton Well Service Pearl River
 date well completed firm name county well located

LANDOWNER: Joe Ryborn
Rt. 4 Box 458
Picayune, MS
 (mailing address)

WELL LOCATION:
 sec. 10 T. 6 S. R. 16 W.
4 miles East of Picayune
 (distance) (direction) (nearest town)

WELL PURPOSE: Home
 (home, irrigation, municipal, industrial)

- WELL COMPLETION DATA:
- (1) diameter (inches) 2"
 - (2) total depth (feet) 1006
 - (3) static water level (feet) 18 below top of ground.
 - (4) casing Galv, 986
 (material) (depth)
2 if telescope see back.
 (size)
 - (5) screen 20', 986
 (length) (depth to top)
2, S. Steel
 (size) (material)
 - (6) pump (HP) (yield gpm)
 (type power)
 - (7) electric log NO
 (yes or no)
 (organization running log)
 - (8) how well bottom plugged B.W.

description of formations encountered	from	to
Surface clay	0	20
sand	20	130
clay	130	340
silt	340	370
clay	370	540
sand	540	690
clay	690	730
sand	730	800
clay	800	900
sand	900	1006

DRILLERS REMARKS:


DEPT. OF NATURAL RESOURCES
 BUREAU OF LAND & WATER RESOURCES

MAY - 6 1982

RECEIVED

If well telescopes please sketch and show depths.

GROUND LEVEL

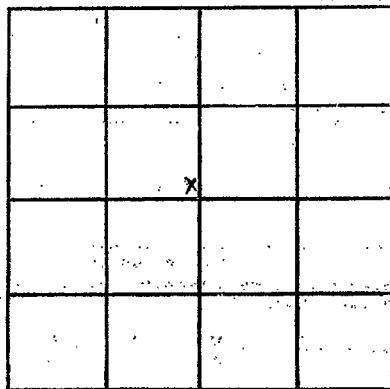

SECTION 4

Please indicate well location X.

ADDITIONAL INFORMATION

If more than one screen,
show locations of each on sketch.