

MISSISSIPPI DEPARTMENT OF NATURAL RESOURCES

Bureau of Land and Water Resources

Southport Mall

P.O. Box 10631

Jackson, Mississippi 39209

WATER WELL DRILLERS LOG

BUD PENTON & SON  
WATER WELL SERVICE

ROUTE BOX  
CARRIERS, MS 39426

PHONE 798-5324

*Paul River*  
*X 2074*

10

*Paul River*  
county well located

4/6 1982  
date well completed

LANDOWNER *Arthur Henley*  
*PO Box 84 Jackson*  
*Miss*  
(mailing address)

WELL LOCATION:  
sec. 19 T. 6 N. R. 16 E.  
S. W.  
E miles 2 of Jackson  
(distance) (direction) (nearest town)

WELL PURPOSE: none  
(home, irrigation, municipal, industrial)

WELL COMPLETION DATA:  
(1) diameter (inches) 2"  
(2) total depth (feet) 2370  
(3) static water level (feet) 21 below above  
top of ground.  
(4) casing PVC, 250,  
(material) (depth)  
(size) If telescope see back.  
(5) screen 10ft, 240  
(length) (depth to top)  
10, PVC  
(size) (material)  
(6) pump 1 660  
(HP) (yield gpm)  
Elect.  
(type power)  
(7) electric log no  
(yes or no)  
(organization running log)

description of formations encountered	from	to
<i>white shale</i>	<i>0</i>	<i>15</i>
<i>Blue shale</i>	<i>15</i>	<i>105</i>
<i>Blue sand</i>	<i>105</i>	<i>160</i>
<i>Blue shale</i>	<i>160</i>	<i>170</i>
<i>Blue sand</i>	<i>170</i>	<i>230</i>

(8) how well bottom plugged  
*Sand Shark*  
DRILLERS REMARKS:


DEPT. OF NATURAL RESOURCES  
BUREAU OF LAND & WATER RESOURCES

JUL - 1 1982

RECEIVED

If well telescopes please sketch and show depths.

GROUND LEVEL

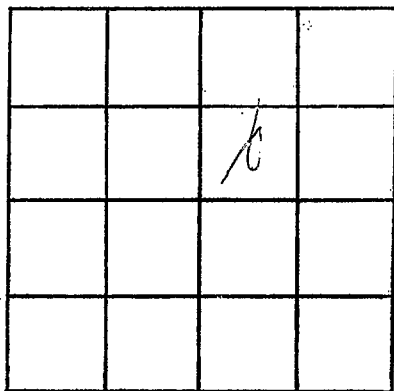

SECTION \_\_\_\_\_

Please indicate well location X.

ADDITIONAL INFORMATION

If more than one screen, show locations of each on sketch.