

Paul Rivers  
X2077

MISSISSIPPI DEPARTMENT OF NATURAL RESOURCES

Bureau of Land and Water Resources

Southport Mall

P.O. Box 10631

Jackson, Mississippi 39209

WATER WELL DRILLERS LOG

BOB PENTON & SON  
WATER WELL SERVICE  
ROUTE 4 BOX 402  
CARRISBORO, MS 39426  
PHONE 798-5324

9/25 1982  
date well completed

Paul Rivers  
county well located

LANDOWNER: Chuck Carter  
PO Box Pacayune  
Miss  
(mailing address)

description of formations encountered	from	to
<u>white shale</u>	<u>0</u>	<u>30</u>
<u>white sand</u>	<u>30</u>	<u>80</u>
<u>Blue shale</u>	<u>80</u>	<u>165</u>
<u>Blue sand</u>	<u>165</u>	<u>200</u>

WELL LOCATION:  
sec. 7 T. 6 N R. 16 E  
S W  
1 miles E of Pacayune  
(distance) (direction) (nearest town)

WELL PURPOSE: home  
(home, irrigation, municipal, industrial)

- WELL COMPLETION DATA:
- (1) diameter (inches) 2"
  - (2) total depth (feet) 200
  - (3) static water level (feet) 29 below above top of ground.
  - (4) casing PVC 200  
(material) (depth)
  - (size) If telescope see back.
  - (5) screen 2x10 190  
(length) (depth to top)
  - 10 PVC  
(size) (material)
  - (6) pump 1/2 450  
(HP) (yield gpm)
  - Elect.  
(type power)
  - (7) electric log no  
(yes or no)

(organization running log)  
(8) how well bottom plugged short


DRILLERS REMARKS:

DEPT. OF NATURAL RESOURCES  
BUREAU OF LAND & WATER RESOURCES

DEC-1 1982  
RECEIVED

If well telescopes please sketch and show depths.

GROUND LEVEL

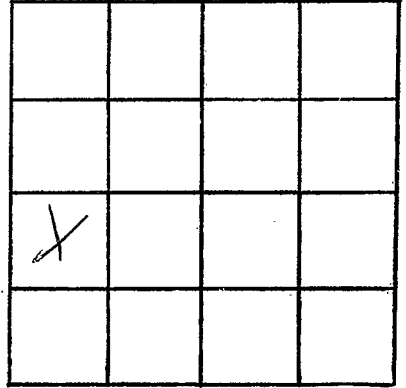

SECTION \_\_\_\_\_

Please indicate well location X.

ADDITIONAL INFORMATION

If more than one screen,  
show locations of each on sketch.