

MISSISSIPPI DEPARTMENT OF NATURAL RESOURCES

Bureau of Land and Water Resources

Southport Mall

P.O. Box 10631

Jackson, Mississippi 39209

WATER WELL DRILLERS LOG

Pearl River  
 X 2078  
 3/24/83

87 POUNCEY WATER WELL DRILLING

Pearl River

3-27-83 date well completed

firm name

county well located

LANDOWNER: MIKE FORE	description of formations encountered	from	to
Rt. 3 Piquette - Salem Court. (mailing address)			
WELL LOCATION: sec. 15 T. 6 N. R. 16 E. 3 miles E of Piquette (distance) (direction) (nearest town)	top -	0	12
WELL PURPOSE: Home (home, irrigation, municipal, industrial)	sl. & gravel	12	48
WELL COMPLETION DATA: (1) diameter (inches) 2	Clay Mix - fine	48	56.2
(2) total depth (feet) 64.2	Brown H. clay - slty. sdy clay	56.2	62.2
(3) static water level (feet) 26 below top of ground.	sl. fine to fair	62.2	63.0
(4) casing PVC, 62.7 (material) (depth)	Big sl. & gravel	63.0	64.2
2 (size) if telescope see back.	Big Bl. det gravel -		
(5) screen 15, 62.7 (length) (depth to top)			
2 (size) PVC (material)			
(6) pump 1/2 (HP) 10 (yield gpm)			
AC (type power)			
(7) electric log (yes or no)			
(organization running log)			
(8) how well bottom plugged Sealed			

DEPT. OF NATURAL RESOURCES  
 BUREAU OF LAND & WATER RESOURCES


MAY 18 1983

RECEIVED

DRILLERS REMARKS: Stack -  
 640' - lost 50'  
 drill pipe - bit & mud.  
 Redrilled.

If well telescopes please sketch and show depths.

GROUND LEVEL

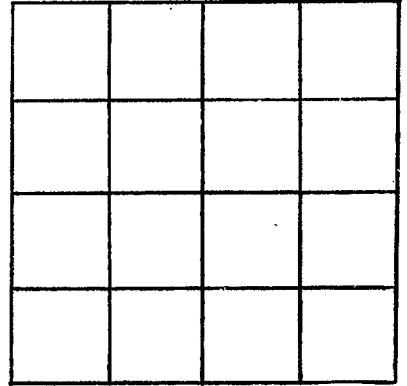

SECTION \_\_\_\_\_

Please indicate well location X.

ADDITIONAL INFORMATION

If more than one screen,  
show locations of each on sketch.