

Jean Rivers  
X 2007

MISSISSIPPI DEPARTMENT OF NATURAL RESOURCES  
 Bureau of Land and Water Resources  
 Southport Mall  
 P.O. Box 10631  
 Jackson, Mississippi 39209  
**WATER WELL DRILLERS LOG**

Bud Peston & Son P. Rivers

date well completed 19

firm name

county well located

LANDOWNER: Wes Peston

description of formations encountered

from

to

B.F.H. Carriere Miss

white shale

0 100

blue shale

100 300

gray sand

300 340

(mailing address)

WELL LOCATION:

sec. 8 T. 6 N. R. 16 E  
 S W  
2 miles East of Missouri  
 (distance) (direction) (nearest town)

WELL PURPOSE: home  
 (home, irrigation, municipal, industrial)

WELL COMPLETION DATA:

- (1) diameter (inches) 2"
- (2) total depth (feet) 340
- (3) static water level (feet) 21 below above top of ground.
- (4) casing pvc 340  
 (material) (depth)  
 (size) if telescope see back.
- (5) screen 10ft. 320  
 (length) (depth to top)  
10 (size) pvc (material)
- (6) pump 1/2 450  
 (HP) (yield gpm)  
Elect (type power)
- (7) electric log no  
 (yes or no)

(organization running log)

(8) how well bottom plugged land  
shut

DRILLERS REMARKS:


DEPT. OF NATURAL RESOURCES  
 BUREAU OF LAND & WATER RESOURCES

JUL 28 1983

RECEIVED

If well telescopes please sketch and show depths.

GROUND LEVEL

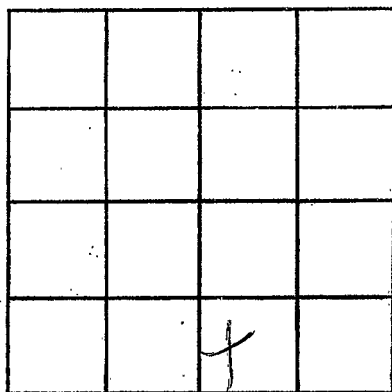

SECTION \_\_\_\_\_

Please indicate well location X.

ADDITIONAL INFORMATION

If more than one screen, show locations of each on sketch.