

MISSISSIPPI DEPARTMENT OF NATURAL RESOURCES

Bureau of Land and Water Resources

Southport Mall

P.O. Box 10631

Jackson, Mississippi 39209

WATER WELL DRILLERS LOG

POUNCEY WATER WELL DRILLING

Paul River

Paul River
X
2081

8-3
date well completed

1983

firm name

county well located

LANDOWNER: *Mickey Bunge*
Rt. 3 Pouncey
Ms.
(mailing address)

description of formations encountered

from to

<i>Top-</i>	0	14
<i>Junk</i>	14	46
<i>Clay ground</i>	46	52
<i>Clay Blue Page</i>	52	70
<i>SD & ground</i>	70	86

WELL LOCATION:

sec. 20 T. 6 N. R. 16 E
2 miles E of Pouncey
(distance) (direction) (nearest town)

WELL PURPOSE: *Home*
(home, irrigation, municipal, industrial)

WELL COMPLETION DATA:

- (1) diameter (inches) 2
- (2) total depth (feet) 86
- (3) static water level (feet) 30 below above top of ground.
- (4) casing PVC 76
(material) (depth)
2 If telescope see back.
(size)
- (5) screen 10 76
(length) (depth to top)
2 PVC
(size) (material)
- (6) pump 1 12
(HP) (yield gpm)
AC-
(type power)
- (7) electric log 1
(yes or no)
(organization running log)
- (8) how well bottom plugged Sealed

DRILLERS REMARKS:


DEPT. OF NATURAL RESOURCES
BUREAU OF LAND & WATER RESOURCES

AUG 26 1983

RECEIVED

If well telescopes please sketch and show depths.

GROUND LEVEL

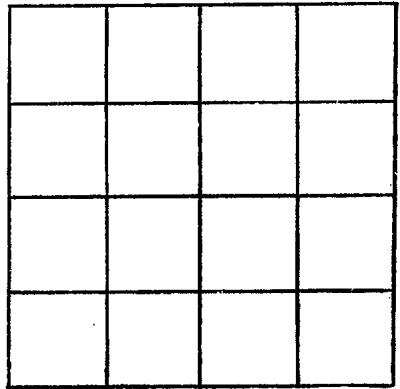

SECTION _____

Please indicate well location X.

ADDITIONAL INFORMATION

If more than one screen, show locations of each on sketch.