

MISSISSIPPI DEPARTMENT OF NATURAL RESOURCES

Bureau of Land and Water Resources

Southport Mall

P.O. Box 10631

Jackson, Mississippi 39209

WATER WELL DRILLERS LOG

BOUNCY WATER WELL DRILLING *Pearl River*

Pearl River
X
2082

8-16
date well completed

19*83*

firm name

county well located

LANDOWNER: *Jimmy Hydenwell*

Sycamore

Description of formations encountered

from

to

(mailing address)

WELL LOCATION:

sec. *7* T. *6* N. R. *16* E.
(S) (W)
2 miles *E* of *Richardson*
(distance) (direction) (nearest town)

WELL PURPOSE: *Flow: AC*
(home, irrigation, municipal, industrial)

WELL COMPLETION DATA:

- (1) diameter (inches) *4 1/2"*
- (2) total depth (feet) *416*
- (3) static water level (feet) *21* below above top of ground.
- (4) casing *PVC 396*
(material) (depth)
4 1/2" (size) If telescope see back.
- (5) screen *20 396*
(length) (depth to top)
2 (size) *PVC* (material)
- (6) pump *1/2 24*
(HP) (yield gpm)
AC (type power)
- (7) electric log */*
(yes or no)
(organization running log)
- (8) how well bottom plugged *Sealed*

<i>TOP</i>	<i>0</i>	<i>11</i>
<i>SD to Big gravel</i>	<i>11</i>	<i>26</i>
<i>Clay</i>	<i>26</i>	<i>230</i>
<i>SD</i>	<i>230</i>	<i>244</i>
<i>Clay</i>	<i>244</i>	<i>360</i>
<i>SD fine</i>	<i>360</i>	<i>416</i>

DEPT. OF NATURAL RESOURCES
BUREAU OF LAND & WATER RESOURCES



AUG 26 1983

RECEIVED

DRILLERS REMARKS:

If well telescopes please sketch and show depths.

GROUND LEVEL

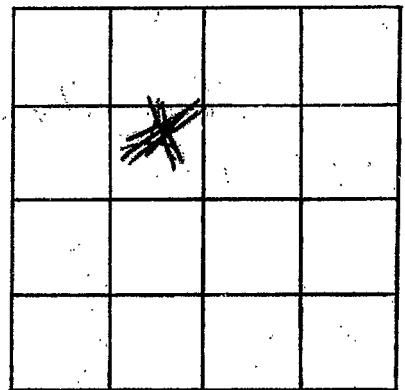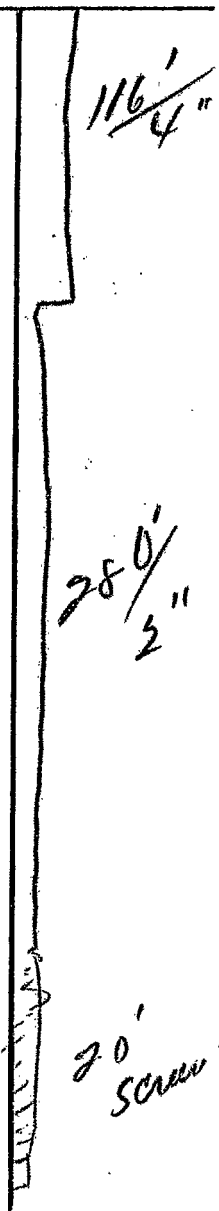

SECTION 7

Please indicate well location X.

ADDITIONAL INFORMATION

*Notes - North wood
Drain.*

If more than one screen,
show locations of each on sketch.