

MISSISSIPPI DEPARTMENT OF NATURAL RESOURCES

Bureau of Land and Water Resources

Pearl River
X
2083

RUD PENTON & SON
 WATER WELL SERVICE
 ROUTE BOX 402
 CARRIERS, MS 39-123
 PHONE 793-6924

Southport Mail
 P.O. Box 1063
 JACKSON, MISSISSIPPI 39209
 PHONE 793-6924

WATER WELL DRILLERS LOG

8/29 19 83 Pearl River
 date well completed firm name county well located

LANDOWNER: <u>Bernell Beach</u>	description of formations encountered	from	to
(mailing address)			
<u>R.T. 3 Pearlane Min</u>	<u>Red shale</u>	<u>0</u>	<u>26</u>
	<u>Red sand</u>	<u>28</u>	<u>41</u>
	<u>Blue shale</u>	<u>41</u>	<u>200</u>
	<u>Gray sand</u>	<u>200</u>	<u>227</u>

WELL LOCATION:
 sec. 6 T 6 N R 16 E
 S W
2 miles E of Pearlane
 (distance) (direction) (nearest town)

WELL PURPOSE: home
 (home, irrigation, municipal, industrial)

- WELL COMPLETION DATA:
- (1) diameter (inches) 2"
 - (2) total depth (feet) 227
 - (3) static water level (feet) 30 below above top of ground.
 - (4) casing pvc 227
 (material) (depth)
 (size) if telescope see back.
 - (5) screen 10 217
 (length) (depth to top)
10 pvc
 (size) (material)
 - (6) pump 1/2 8
 (HP) (yield gpm)
Ele
 (type power)
 - (7) electric log no
 (yes or no)
 (organization running log)
 - (8) how well bottom plugged shard

DEPT. OF NATURAL RESOURCES
 BUREAU OF LAND & WATER RESOURCES


NOV 18 1983

RECEIVED

DRILLERS REMARKS:

If well telescopes please sketch and show depths.

GROUND LEVEL

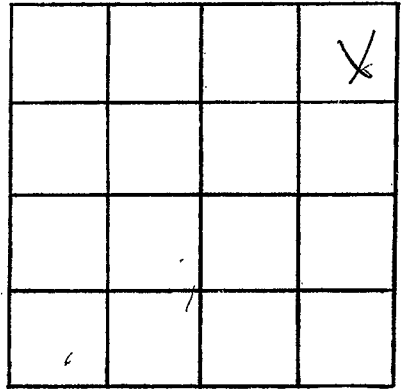

SECTION _____

Please indicate well location X.

ADDITIONAL INFORMATION

If more than one screen, show locations of each on sketch.