

Gal River
 X2084

MISSISSIPPI DEPARTMENT OF NATURAL RESOURCES
 Bureau of Land and Water Resources
 Southport Mall
 Jackson, Mississippi 39209
 WATER WELL DRILLERS LOG

BUD PENTON & SON
 WATER WELL SERVICE
 ROUTE 4 BOX 402
 CARRIERS, MS 39223
 PHONE 733-5224

11/15 1983
 date well completed

Gal River
 firm name county well located

LANDOWNER: *Don J. Faison*
P.O. Pigeon P.O.
 (mailing address)

description of formations encountered	from	to
	<i>Red shale</i>	<i>0</i>
<i>Whit sand</i>	<i>10</i>	<i>60</i>
<i>Blue shale</i>	<i>60</i>	<i>400</i>
<i>Grey sand</i>	<i>400</i>	<i>420</i>

WELL LOCATION:
 sec. 6 T. 6 N R. 16 E
 S W
1 East miles *East* of *Pigeon*
 (distance) (direction) (nearest town)

WELL PURPOSE: *home*
 (home, irrigation, municipal, industrial)

- WELL COMPLETION DATA:
- (1) diameter (inches) 2"
 - (2) total depth (feet) 420
 - (3) static water level (feet) 21 below above top of ground.
 - (4) casing PVC 400
 (material) (depth)
 (size) if telescope see back.
 - (5) screen 10ft 410
 (length) (depth to top)
10 PVC
 (size) (material)
 - (6) pump 1 650
 (HP) (yield gpm)
Ele.
 (type power)
 - (7) electric log no
 (yes or no)
 - (8) how well bottom plugged hard
sharp

DRILLERS REMARKS:


DEPT. OF NATURAL RESOURCES
 BUREAU OF LAND & WATER RESOURCES

MAR 23 1984

RECEIVED

If well telescopes please
sketch and show depths.

GROUND LEVEL

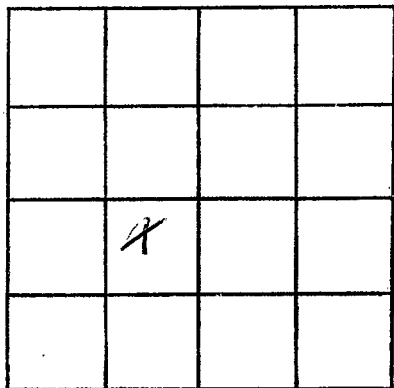

SECTION _____

Please indicate well location X.

ADDITIONAL INFORMATION

If more than one screen,
show locations of each on sketch.