

MISSISSIPPI DEPARTMENT OF NATURAL RESOURCES

Bureau of Land and Water Resources

Southport Mall

P.O. Box 10631

Jackson, Mississippi 39209

WATER WELL DRILLERS LOG

Pearl River
X 2087

POUNCEY WATER WELL DRILLING

Pearl River

3-20-74
 date well completed

firm name

county well located

LANDOWNER:

Shene Carter

description of formations encountered

from

to

Hy 43 East

Top 0 8

(mailing address)

cd set. 8 24

WELL LOCATION:

sec. 70 T. 6 N R. 16 E
2 miles EAST of PICAYUNE
 (distance) (direction) (nearest town)

Clay Hd. some 24 43

grey Blue
light brown sd. 43 74

WELL PURPOSE:

(home, irrigation, municipal, industrial)

fine green sd. 74 80

WELL COMPLETION DATA:

- (1) diameter (inches) 2
- (2) total depth (feet) 80
- (3) static water level (feet) 14 below above top of ground
- (4) casing PVC 70
 (material) (depth)
2
 (size) if telescope see back.
- (5) screen 10 70
 (length) (depth to top)
2 PVC
 (size) (material)
- (6) pump 1 25
 (HP) (yield gpm)
pc
 (type power)
- (7) electric log
 (yes or no)

 (organization running log)
- (8) how well bottom plugged

DRILLERS REMARKS:


DEPT. OF NATURAL RESOURCES
 BUREAU OF LAND & WATER RESOURCES

APR 2 1984

RECEIVED

If well telescopes please
sketch and show depths.

GROUND LEVEL

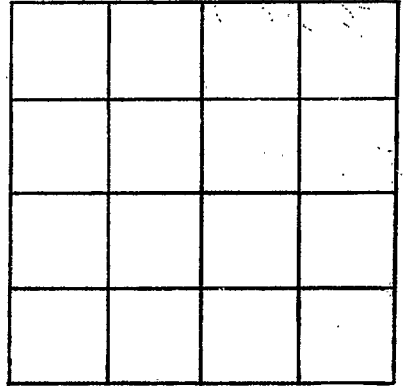

SECTION _____

Please indicate well location X.

ADDITIONAL INFORMATION

If more than one screen,
show locations of each on sketch.