

MISSISSIPPI DEPARTMENT OF NATURAL RESOURCES

Bureau of Land and Water Resources

Southport Mall

P.O. Box 10631

Jackson, Mississippi 39209

WATER WELL DRILLERS LOG

Paul Turner
X 2288

Pearl River

2-9-84 / 19 *POUNCEY WATER WELL DRILLING* / *Pearl River*
date well completed firm name county well located

| LANDOWNER: | description of formations encountered | from | to |
|--|---------------------------------------|-----------|-----------|
| <i>Aug Mitchell</i> | <i>TOP</i> | <i>0</i> | <i>14</i> |
| <i>ole Salem Packer's</i> | <i>sd.</i> | <i>14</i> | <i>47</i> |
| <i>plot - pct 3</i> | <i>sd good some clay</i> | <i>47</i> | <i>54</i> |
| (mailing address) | | | |
| WELL LOCATION: | | | |
| sec. <i>20</i> T. <i>6</i> N. R. <i>16</i> E. W. <i>1</i> | | | |
| <i>2</i> miles <i>E</i> of <i>Pickens</i> | | | |
| (distance) (direction) (nearest town) | | | |
| WELL PURPOSE: <i>For animals</i> | | | |
| (home, irrigation, municipal, industrial) | | | |
| WELL COMPLETION DATA: | | | |
| (1) diameter (inches) <i>2</i> | | | |
| (2) total depth (feet) <i>54</i> | | | |
| (3) static water level (feet) <i>18</i> below top of ground | | | |
| (4) casing <i>PVC</i> (material) <i>44</i> (depth) | | | |
| (size) if telescope see back. | | | |
| (5) screen <i>10</i> (length) <i>44</i> (depth to top) | | | |
| (size) (material) <i>PVC</i> | | | |
| (6) pump <i>1</i> (HP) <i>20</i> (yield gpm) | | | |
| (type power) <i>AC 220V</i> | | | |
| (7) electric log <input checked="" type="checkbox"/> (yes or no) | | | |
| (organization running log) | | | |
| (8) how well bottom plugged | | | |

DEPT. OF NATURAL RESOURCES
BUREAU OF LAND & WATER RESOURCES


APR 12 1984

RECEIVED

DRILLERS REMARKS:

If well telescopes please
sketch and show depths.

GROUND LEVEL

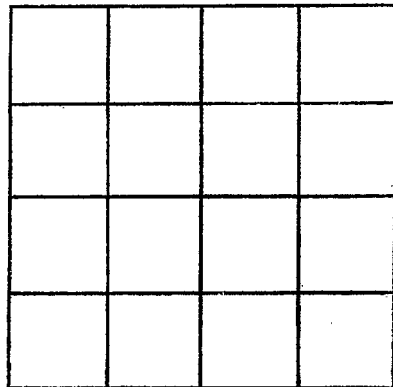

SECTION _____

Please indicate well location X.

ADDITIONAL INFORMATION

If more than one screen,
show locations of each on sketch.