

MISSISSIPPI DEPARTMENT OF NATURAL RESOURCES

Bureau of Land and Water Resources

Southport Mall

P.O. Box 10631

Jackson, Mississippi 39209

WATER WELL DRILLERS LOG

Paul Rivers  
XASW

POUNCEY WATER WELL Paul Rivers

6-13-84 date well completed

firm name

county well located

LANDOWNER:

Candy Pigott

description of formations encountered

from

to

R13 Poyayun (mailing address)

Top  
S.D. Clay  
Clay  
S.D.

0 12  
12 36  
36 208  
208 27

WELL LOCATION:

sec 19 T 6 N R 16 E  
1 miles E of Poyayun  
(distance) (direction) (nearest town)

WELL PURPOSE: House  
(home, irrigation, municipal, industrial)

WELL COMPLETION DATA:

- (1) diameter (inches) 2
- (2) total depth (feet) 278
- (3) static water level (feet) 47 below top of ground
- (4) casing PVC 268 (material) (depth)
- (size) 2 if telescope see back.
- (5) screen 10 268 (length) (depth to top)
- (size) 2 (material) PVC
- (6) pump 1 10 (HP) (yield gpm)
- (type power) AC
- (7) electric log (yes or no)

(organization running log)

(8) how well bottom plugged Sealed

DEPT. OF NATURAL RESOURCES  
BUREAU OF LAND & WATER RESOURCES


SEP 10 1984

RECEIVED

DRILLERS REMARKS:

If well telescopes please  
sketch and show depths.

GROUND LEVEL

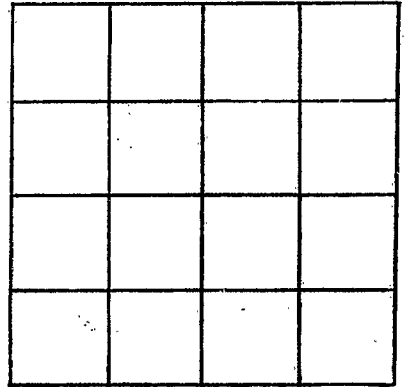

SECTION \_\_\_\_\_

Please indicate well location X.

ADDITIONAL INFORMATION

If more than one screen,  
show locations of each on sketch.