

MISSISSIPPI DEPARTMENT OF NATURAL RESOURCES

Bureau of Land and Water Resources

Southport Mall

P.O. Box 10631

Jackson, Mississippi 39209

WATER WELL DRILLERS LOG

Red River
X 1072

POUNCEY WATER WELL DRILLING Red River

7-23 1984 date well completed firm name county well located

LANDOWNER: Billy Regott
RD 3 Pouncey
Ms.
 (mailing address)

WELL LOCATION:
 sec. 19 T. 6 N R. 16 E
1 miles E of Pouncey
 (distance) (direction) (nearest town)

WELL PURPOSE: Home
 (home, irrigation, municipal, industrial)

- WELL COMPLETION DATA:
- (1) diameter (inches) 2
 - (2) total depth (feet) 246
 - (3) static water level (feet) 32 below above top of ground.
 - (4) casing PVC 236
 (material) (depth)
2 if telescope see back.
 (size)
 - (5) screen 10 236
 (length) (depth to top)
2 PVC
 (size) (material)
 - (6) pump 1 8
 (HP) (yield gpm)
AC
 (type power)
 - (7) electric log _____
 (yes or no)

 (organization running log)
 - (8) how well bottom plugged _____

description of formations encountered	from	to
	<u>Top.</u>	<u>0</u>
<u>SD.</u>	<u>13</u>	<u>21</u>
<u>Clay</u>	<u>21</u>	<u>36</u>
<u>SD.</u>	<u>36</u>	<u>44</u>
<u>Clay</u>	<u>44</u>	<u>236</u>
<u>SD.</u>	<u>236</u>	<u>249</u>
<u>HD Clay</u>	<u>244</u>	<u>246</u>

DEPT. OF NATURAL RESOURCES
 BUREAU OF LAND & WATER RESOURCES


SEP 10 1984

RECEIVED

DRILLERS REMARKS:

If well telescopes please sketch and show depths.

GROUND LEVEL

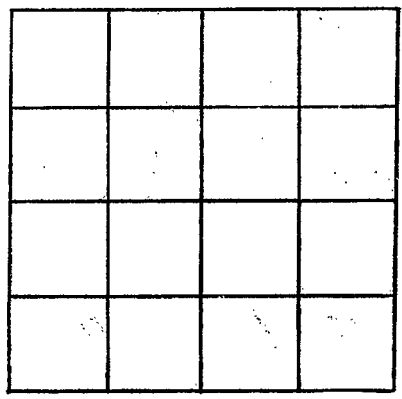

SECTION _____

Please indicate well location X.

ADDITIONAL INFORMATION

A series of horizontal lines for recording additional information, starting below the 'ADDITIONAL INFORMATION' header and extending to the bottom of the page.

If more than one screen, show locations of each on sketch.