

MISSISSIPPI DEPARTMENT OF NATURAL RESOURCES

Bureau of Land and Water Resources

Southport Mall

P.O. Box 10631

Jackson, Mississippi 39209

WATER WELL DRILLERS LOG

PEARL RIVER  
X 2095  
8/10/85

8-10

1985 PENTON WELL SERV.

PEARL RIVER

date well completed

firm name

county well located

LANDOWNER: H. C. VICKMAIR

RT. 5 1200 HAVEN RD.

(mailing address)

WELL LOCATION:

sec 19 T. 6 S R. 16 W  
1 miles E of PICAYUNE  
(distance) (direction) (nearest town)

WELL PURPOSE: HOME  
(home, irrigation, municipal, industrial)

WELL COMPLETION DATA:

- (1) diameter (inches) 2"
- (2) total depth (feet) 365'
- (3) static water level (feet) 20' below top of ground.
- (4) casing PVC 355'  
(material) (depth)
- 2" (size) if telescope see back.
- (5) screen 10' 355'  
(length) (depth to top)
- 2" PVC  
(size) (material)
- (6) pump 1 (HP) (yield gpm)
- Elec  
(type power)
- (7) electric log NO  
(yes or no)

(organization running log)

(8) how well bottom plugged B.W.

description of formations encountered

from

to

|             |     |     |
|-------------|-----|-----|
| CLAY        | 0   | 15  |
| SAND        | 15  | 40  |
| CLAY        | 40  | 70  |
| SAND & CLAY | 70  | 300 |
| SAND        | 300 | 365 |


RECEIVED  
SEP - 9 1985

Department of Natural Resources  
Bureau of Land & Water Resources

DRILLERS REMARKS:

If well telescopes please sketch and show depths.

GROUND LEVEL

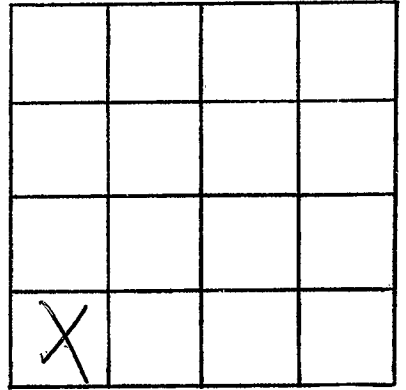

SECTION \_\_\_\_\_

Please indicate well location X.

ADDITIONAL INFORMATION

If more than one screen,  
show locations of each on sketch.