

MISSISSIPPI DEPARTMENT OF NATURAL RESOURCES

Bureau of Land and Water Resources

Southport Mall

P.O. Box 10631

Jackson, Mississippi 39209

WATER WELL DRILLERS LOG

PEARL RIVER
~~X~~ NO DATA
9-13-85

9/13 1985 PENTON TSON Pearl River
 date well completed firm name county well located

LANDOWNER: Bobby Manning
PO Box 835 Osprey City
Call 93435
 (mailing address)

description of formations encountered	from	to
<u>Red shale</u>	<u>0</u>	<u>20</u>
<u>Blue shale</u>	<u>20</u>	<u>550</u>
<u>Grey sand</u>	<u>550</u>	<u>600</u>

WELL LOCATION:
 sec. 14 T. 6 N R. 16 E
12 miles E of Osprey
 (distance) (direction) (nearest town)

WELL PURPOSE: home
 (home, irrigation, municipal, industrial)

WELL COMPLETION DATA:

(1) diameter (inches) 2

(2) total depth (feet) 600

(3) static water level (feet) 6 below above top of ground.

(4) casing PVC, 600,
 (material) (depth)
NO if telescope see back.
 (size)

(5) screen 2x10, 5-80
 (length) (depth to top)
12, PVC
 (size) (material)

(6) pump 1/2 450
 (HP) (yield gpm)
Elect
 (type power)

(7) electric log NO
 (yes or no)

(organization running log)

(8) how well bottom plugged shut


DRILLERS REMARKS:

RECEIVED
 NOV 20 1985

Department of Natural Resources
 Bureau of Land & Water Resources

If well telescopes please sketch and show depths.

GROUND LEVEL

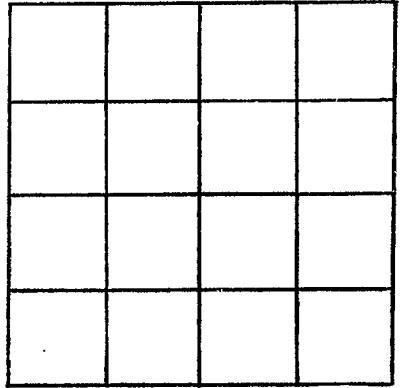

SECTION _____

Please indicate well location X.

ADDITIONAL INFORMATION

If more than one screen,
show locations of each on sketch.