

MISSISSIPPI DEPARTMENT OF NATURAL RESOURCES

Bureau of Land and Water Resources

Southport Mall

P.O. Box 10631

Jackson, Mississippi 39209

WATER WELL DRILLERS LOG

PEARL RIVER
X 2009

3-14-86 19 POUNCEY WATER WELL DRILLING Pearl River
date well completed firm name county well located

LANDOWNER: Danny Martin

description of formations encountered

from to

(mailing address)

WELL LOCATION:

sec 8 T 06 N R 16 E
1 1/2 miles E of N. P. 14 S
(distance) (direction) (nearest town)

WELL PURPOSE: Domestic
(home, irrigation, municipal, industrial)

WELL COMPLETION DATA:

- (1) diameter (inches) 4 1/2
- (2) total depth (feet) 368
- (3) static water level (feet) 32 below top of ground.
- (4) casing PV 348
(material) (depth)
If telescope see back.
(size)
- (5) screen 20 348
(length) (depth to top)
2 PVC
(size) (material)
- (6) pump 3 1/2 120
(HP) (yield gpm)
AE
(type power)
- (7) electric log (yes or no)
- (organization running log)
- (8) how well bottom plugged Sealed.

top	0	12
sd gravel - loess	12	61
0 Red, yellow	61	236
white		
Brown red clay	236	320
sd in sd	320	368

RECEIVED

MAR 25 1986



DRILLERS REMARKS:

Test in
rd well sd 20'
Bore and lens

Department of Natural Resources
Bureau of Land & Water Resources

If well telescopes please sketch and show depths.

GROUND LEVEL

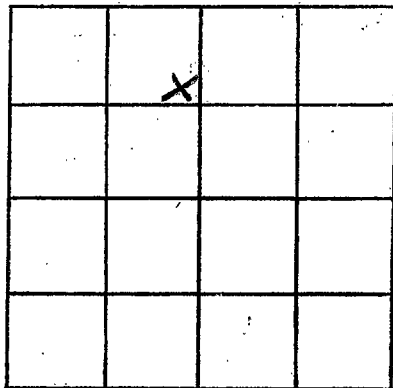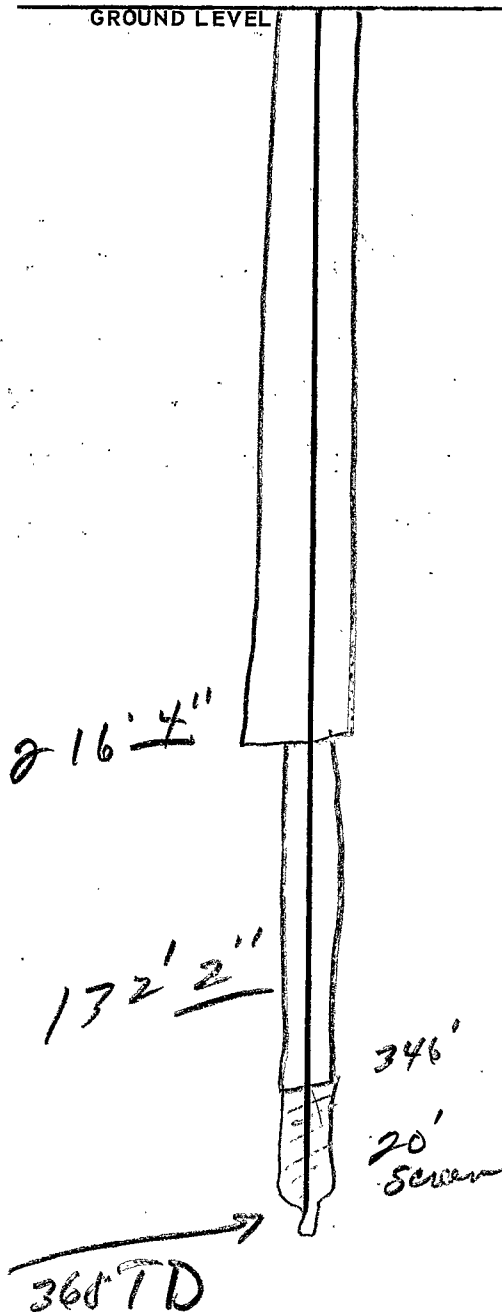

SECTION 8

Please indicate well location X.

ADDITIONAL INFORMATION

If more than one screen, show locations of each on sketch.