

MISSISSIPPI DEPARTMENT OF NATURAL RESOURCES

Bureau of Land and Water Resources

Southport Mall

P.O. Box 10631

Jackson, Mississippi 39209

WATER WELL DRILLERS LOG

Peace River
X 2100

date well completed 4-8-86 firm name Paoney water well Dr. Peace River county well located _____

LANDOWNER: Spence Carter
114 43 east.
(mailing address)

WELL LOCATION:
sec. 17 T 6 N R. 16 E
1 1/2 miles E of Picayune
(distance) (direction) (nearest town)

WELL PURPOSE: Home
(home, irrigation, municipal, industrial)

- WELL COMPLETION DATA:
- (1) diameter (inches) 2
 - (2) total depth (feet) 732
 - (3) static water level (feet) ground below above top of ground.
 - (4) casing PVC 732
(material) (depth)
2 If telescope see back.
(size)
 - (5) screen 10 732
(length) (depth to top)
2 PVC
(size) (material)
 - (6) pump 1 1/2 26
(HP) (yield gpm)
PC
(type power)
 - (7) electric log _____
(yes or no)
(organization running log)
 - (8) how well bottom plugged Sealed


description of formations encountered	from	to
<u>10 ft</u>	<u>0</u>	<u>10</u>
<u>10</u>	<u>10</u>	<u>20</u>
<u>clay</u>	<u>30</u>	<u>41</u>
<u>shallow gravel</u>	<u>41</u>	<u>69</u>
<u>clay</u>	<u>69</u>	<u>192</u>
<u>clay - some silt</u>	<u>192</u>	<u>280</u>
<u>clay</u>	<u>280</u>	<u>346</u>
<u>silt</u>	<u>346</u>	<u>382</u>
<u>clay</u>	<u>382</u>	<u>416</u>
<u>silt</u>	<u>416</u>	<u>430</u>
<u>silt</u>	<u>430</u>	<u>490</u>
<u>clay</u>	<u>490</u>	<u>620</u>
<u>clay to sand</u>	<u>620</u>	<u>682</u>

RECEIVED
MAY 20 1986
Department of Natural Resources
Bureau of Land & Water Resources

DRILLERS REMARKS:

If well telescopes please sketch and show depths.

GROUND LEVEL

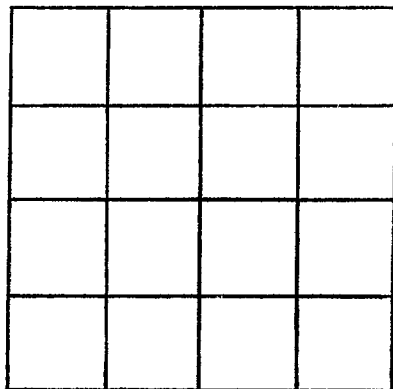

SECTION _____

Please indicate well location X.

ADDITIONAL INFORMATION

If more than one screen,
show locations of each on sketch.