

MISSISSIPPI DEPARTMENT OF NATURAL RESOURCES

Bureau of Land and Water Resources

Southport Mall

P.O. Box 10631

Jackson, Mississippi 39209

WATER WELL DRILLERS LOG

Water Well Service

Rt. 4, Box 402

Carriere, Mississippi 39426

Pearl River

county well located

PEARL RIVER
X 2102

5-19 1986
date well completed

LANDOWNER:

Geertus

Enterprise

Picayune Miss
(mailing address)

Phone 601 - 798-5324
description of formations encountered

from

to

Red shale

0 30

Red sand

30 80

Blue shale

80 300

Blue shale

300 360

WELL LOCATION:

sec. 17 T. 6 N R. 16 E
S W

3 miles SE of Picayune
(distance) (direction) (nearest town)

WELL PURPOSE:

home
(home, irrigation, municipal, industrial)

WELL COMPLETION DATA:

- (1) diameter (inches) 2"
- (2) total depth (feet) 360
- (3) static water level (feet) 42 below top of ground.

(4) casing PVC 360
(material) (depth)

no if telescope see back.
(size)

(5) screen 10 350
(length) (depth to top)

10 PVC
(size) (material)

(6) pump 1 460
(HP) (yield gpm)

Elect.
(type power)

(7) electric log no
(yes or no)

(organization running log)

(8) how well bottom plugged short


DRILLERS REMARKS:

RECEIVED
MAY 3 1986

Department of Natural Resources
Bureau of Land & Water Resources

If well telescopes please sketch and show depths.

GROUND LEVEL

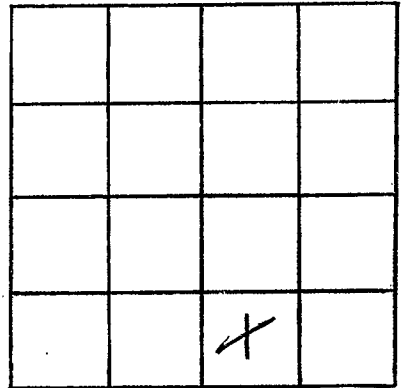

SECTION _____

Please indicate well location X.

ADDITIONAL INFORMATION

If more than one screen,
show locations of each on sketch.