

MISSISSIPPI DEPARTMENT OF NATURAL RESOURCES

Bureau of Land and Water Resources

Southport Mall

P.O. Box 10631

Jackson, Mississippi 39209

WATER WELL DRILLERS LOG

BOUNCY WATER WELL DRILLING

PEARL RIVER
X 2103

6-21-1982
date well completed

firm name

Pearl River
county well located

LANDOWNER: Tom McDonald

description of formations encountered

from to

Sycamore

(mailing address)

WELL LOCATION:

sec 6 T 6 N R 16 E
S
1 1/2 miles E of Phaynes
(distance) (direction) (nearest town)

WELL PURPOSE: Home
(home, irrigation, municipal, industrial)


WELL COMPLETION DATA:

- (1) diameter (inches) 2
- (2) total depth (feet) 405
- (3) static water level (feet) 50 below above top of ground.
- (4) casing PVC 395
(material) (depth)
2 If telescope see back.
(size)
- (5) screen 10 395
(length) (depth to top)
2 PVC
(size) (material)
- (6) pump 1 12
(HP) (yield gpm)
AC
(type power)
- (7) electric log yes or no

(organization running log)

(8) how well bottom plugged Sealed

<u>Top</u>	<u>0</u>	<u>8</u>
<u>sd gravel</u>	<u>8</u>	<u>46</u>
<u>Clay</u>	<u>46</u>	<u>201</u>
<u>Set.</u>	<u>201</u>	<u>240</u>
<u>Clay</u>	<u>240</u>	<u>260</u>
<u>Set. very fine sd.</u>	<u>260</u>	<u>294</u>
<u>Clay some brown</u>	<u>294</u>	<u>351</u>
<u>sd fine gravel</u>	<u>351</u>	<u>405</u>

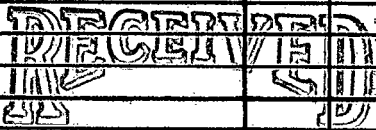


JUL 01 1986

Department of Natural Resources
Bureau of Land & Water Resources

DRILLERS REMARKS:

If well telescopes please sketch and show depths.

GROUND LEVEL

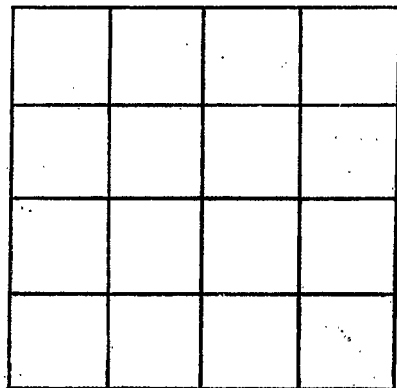

SECTION _____

Please indicate well location X.

ADDITIONAL INFORMATION

If more than one screen,
show locations of each on sketch.