

MISSISSIPPI DEPARTMENT OF NATURAL RESOURCES

Bureau of Land and Water Resources

Southport Mall

P.O. Box 10631

Jackson, Mississippi 39209

WATER WELL DRILLERS LOG

BOUNCEY WATER WELL DRILLING

Pearl River

PEARL RIVER
X2104

8-6
date well completed

firm name

county well located

LANDOWNER: *Permin Whitfield*

description of formations encountered

from

to

Salem oak

14 13

(mailing address)

top 0 6
SD, good on bottom 6 54

WELL LOCATION:


sec 21 T 6 N R 16 E
3 1/2 miles E of Picayune
(distance) (direction) (nearest town)

WELL PURPOSE: *for drinking*
(home, irrigation, municipal, industrial)

WELL COMPLETION DATA:

- (1) diameter (inches) 2
- (2) total depth (feet) 54
- (3) static water level (feet) 16 below above top of ground
- (4) casing PVC 44
(material) (depth)
2 if telescope see back.
(size)
- (5) screen 10 44
(length) (depth to top)
2 PVC
(size) (material)
- (6) pump 1/2 12
(HP) (yield gpm)
AC
(type power)
- (7) electric log
(yes or no)

(organization running log)
- (8) how well bottom plugged Sealed

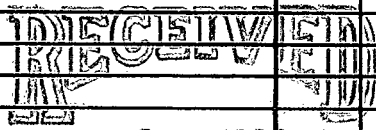


SEP 29 1966

Department of Natural Resources
Bureau of Land & Water Resources

DRILLERS REMARKS:

If well telescopes please
sketch and show depths.

GROUND LEVEL

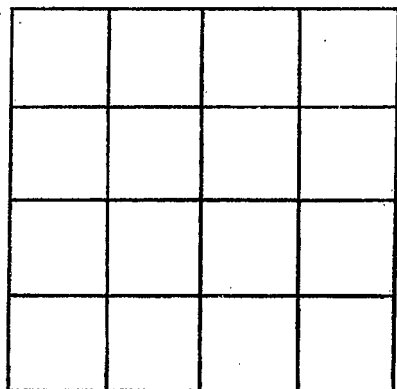

SECTION _____

Please indicate well location X.

ADDITIONAL INFORMATION

If more than one screen,
show locations of each on sketch.