

PEARL RIVER  
X 2105

MISSISSIPPI DEPARTMENT OF NATURAL RESOURCES  
Bureau of Land and Water Resources  
Southport Mall  
P.O. Box 10631  
Jackson, Mississippi 39209  
WATER WELL DRILLERS LOG

POUNCEY WATER WELL DRILLING Pearl River  
date well completed 5-13-1986 firm name county well located

LANDOWNER: Joseph A. Bounds  
Plantation Oaks  
Hwy 43 E  
(mailing address)

WELL LOCATION:  
sec 20 T 6 N R 16 E  
S W  
2 miles E of Pritchard  
(distance) (direction) (nearest town)

WELL PURPOSE: House  
(home, irrigation, municipal, industrial)

- WELL COMPLETION DATA:
- (1) diameter (inches) 4
  - (2) total depth (feet) 512
  - (3) static water level (feet) 48 below top of ground.
  - (4) casing PVC 492  
(material) (depth)  
4 If telescope see back.  
(size)
  - (5) screen 20 492  
(length) (depth to top)  
2 PVC  
(size) (material)
  - (6) pump 1/2 30  
(HP) (yield gpm)  
(type power)
  - (7) electric log ~~yes~~  
(yes or no)
  - (organization running log)
  - (8) how well bottom plugged Sealed.

description of formations encountered	from	to
top	0	16
Clay	16	18
SD	18	28
shaly sd.	28	480
good sd.	480	500
fine sd.	480	512


RECEIVED  
SEP 9 9 1986

Department of Natural Resources  
Bureau of Land & Water Resources

DRILLERS REMARKS:

If well telescopes please sketch and show depths.

GROUND LEVEL

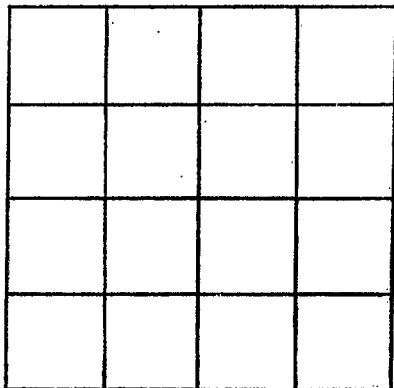

SECTION \_\_\_\_\_

Please indicate well location X.

ADDITIONAL INFORMATION

If more than one screen,  
show locations of each on sketch.