

MISSISSIPPI DEPARTMENT OF NATURAL RESOURCES

Bureau of Land and Water Resources

Southport Mall

P.O. Box 10631

Jackson, Mississippi 39209

BUD PENTON DRILL & SOLOS

Water Well Service

Rt. 4, Box 402

Warrens, Mississippi 39428

Phone 601-798-5324

LEARN RIVER
X 2100

9/11 1986
date well completed

Learn River
county well located

LANDOWNER: M W Stafford

Rt. 3 Box 270 Carriere

MS

(mailing address)

WELL LOCATION:

sec. 6 T. 10 N. R. 16 E. S. 1 W.

East 1 miles East of Warrens
(distance) (direction) (nearest town)

WELL PURPOSE: None
(home, irrigation, municipal, industrial)

WELL COMPLETION DATA:

- (1) diameter (inches) 2"
- (2) total depth (feet) 795
- (3) static water level (feet) 45 below above top of ground.

(4) casing PVC 795
(material) (depth)

(size) if telescope see back.

10 (5) screen 10 785
(length) (depth to top)

12 PVC
(size) (material)

(6) pump no
(HP) (yield gpm)

(type power)

(7) electric log no
(yes or no)

(organization running log)

(8) how well bottom plugged plugged
sharp

DRILLERS REMARKS:

description of formations encountered

from

to

<u>Red shale</u>	<u>0</u>	<u>30</u>
<u>Red sand</u>	<u>30</u>	<u>45</u>
<u>Blue shale</u>	<u>45</u>	<u>175</u>
<u>Blue sand</u>	<u>175</u>	<u>210</u>
<u>Blue shale</u>	<u>210</u>	<u>735</u>
<u>Gray sand</u>	<u>735</u>	<u>795</u>

BUD PENTON & SOLOS

Water Well Service

Rt. 4, Box 402

Carriere, Mississippi 39428

Phone 601-798


RECEIVED

APR 21 1987

Department of Natural Resources
Bureau of Land & Water Resources

If well telescopes please sketch and show depths.

GROUND LEVEL

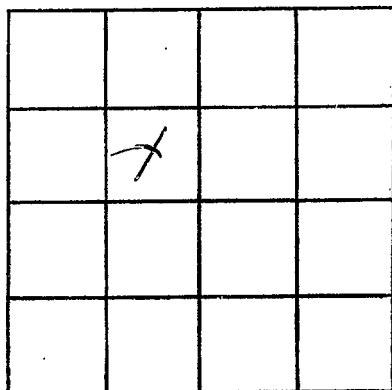

SECTION _____

Please indicate well location X.

ADDITIONAL INFORMATION

If more than one screen, show locations of each on sketch.