

MISSISSIPPI DEPARTMENT OF NATURAL RESOURCES

Bureau of Land and Water Resources

Southport Mall

P.O. Box 10631

Jackson, Mississippi 39209

WATER WELL DRILLERS LOG

Paul Lee
X 2109

1/26 19 *87* *Bud Peterson* *Paul Remy*
 date well completed firm name county well located
Water Well

LANDOWNER: *Mary Hoffman*
R.T. Box 320
Piquette Miss.
 (mailing address)

Description of formations encountered	from	to
<i>Red shale</i>	<i>0</i>	<i>30</i>
<i>White sand</i>	<i>30</i>	<i>75</i>
<i>Blue shale</i>	<i>75</i>	<i>320</i>
<i>Blue sand</i>	<i>320</i>	<i>416</i>

WELL LOCATION:
 sec. *9* T. *6* N R. *16* E
1/2 miles *East* of *Piquette*
 (distance) (direction) (nearest town)

WELL PURPOSE: *home*
 (home, irrigation, municipal, industrial)

WELL COMPLETION DATA:

- (1) diameter (inches) *2*
- (2) total depth (feet) *416*
- (3) static water level (feet) *35* below above top of ground.
- (4) casing *pvc* *416*,
 (material) (depth)
- (size) if telescope see back.
- (5) screen *10* *406*
 (length) (depth to top)
- 12* *pvc*
 (size) (material)
- (6) pump *1/2* *450*
 (HP) (yield gpm)
- Elect.*
 (type power)
- (7) electric log *no*
 (yes or no)

RECEIVED
 JUN 12 1987

Department of Natural Resources
 Bureau of Land & Water Resources


(organization running log)

(8) how well bottom plugged *sand*

DRILLERS REMARKS: *Sherk*

If well telescopes please sketch and show depths.

GROUND LEVEL

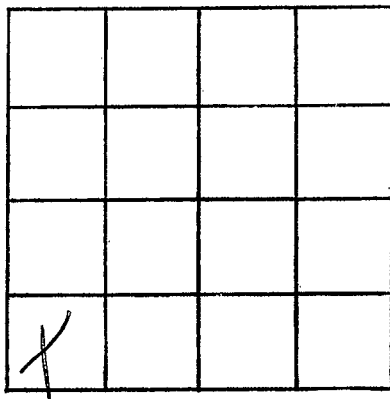

SECTION _____

Please indicate well location X.

ADDITIONAL INFORMATION

If more than one screen, show locations of each on sketch.