

MISSISSIPPI DEPARTMENT OF NATURAL RESOURCES

Bureau of Land and Water Resources

Southport Mall

P.O. Box 10631

Jackson, Mississippi 39209

WATER WELL DRILLERS LOG

Pearl River
X 2112

9/5 1987 Red Penton Pearl River
date well completed firm name county well located
Water Well Service

LANDOWNER: Robert E. Guthrie
RT. 1 Box 445-B
Picayune Miss 39466
(mailing address)

Description of formations encountered	from	to
<u>Red shale</u>	<u>0</u>	<u>21</u>
<u>white sand</u>	<u>21</u>	<u>58</u>
<u>Blue shale</u>	<u>58</u>	<u>175</u>
<u>white sand</u>	<u>175</u>	<u>210</u>
<u>Blue shale</u>	<u>210</u>	<u>600</u>
<u>Sand</u>	<u>600</u>	<u>630</u>

WELL LOCATION:
sec. 16 T 6 N R 16 E
S W
2 miles 3 of Picayune
(distance) (direction) (nearest town)

WELL PURPOSE: home
(home, irrigation, municipal, industrial)

- WELL COMPLETION DATA:
- (1) diameter (inches) 2"
 - (2) total depth (feet) 630
 - (3) static water level (feet) 60 below/above top of ground.
 - (4) casing PVC 620
(material) (depth)
20 if telescope see back.
(size)
 - (5) screen 10 620
(length) (depth to top)
12" PVC
(size) (material)
 - (6) pump 1 650
(HP) (yield gpm)
Elect
(type power)
 - (7) electric log no
(yes or no)

(organization running log)
(8) how well bottom plugged Standard
Start

DRILLERS REMARKS:


RECEIVED

ADD 1 - 1000

MISSISSIPPI DEPARTMENT OF NATURAL RESOURCES
Bureau of Land and Water Resources

If well telescopes please sketch and show depths.

GROUND LEVEL

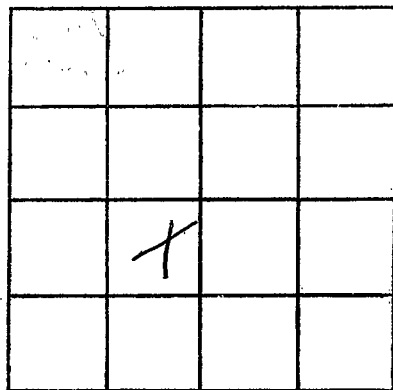

SECTION _____

Please indicate well location X.

ADDITIONAL INFORMATION

If more than one screen,
show locations of each on sketch.