

MISSISSIPPI DEPARTMENT OF NATURAL RESOURCES

Bureau of Land and Water Resources

Southport Mall

P.O. Box 10631

Jackson, Mississippi 39209

WATER WELL DRILLERS LOG

P. L. Over
X 217

date well completed 19 ' Budperton & Son firm name Pearl River county well located

LANDOWNER: <u>Jeanie Meany</u>	description of formations encountered	from	to
<u>PO Box 43 Eubank</u>		<u>Red shale</u>	<u>0</u>
<u>Road Picayune Miss</u> (mailing address)	<u>White sand</u>	<u>15-</u>	<u>125-</u>
	<u>Blue shale</u>	<u>125-</u>	<u>180</u>
	<u>gray sand</u>	<u>180</u>	<u>210</u>

WELL LOCATION:
sec. 6 T. 6 N. R. 16 E
S W
2 miles East of Picayune
(distance) (direction) (nearest town)

WELL PURPOSE: home
(home, irrigation, municipal, industrial)

- WELL COMPLETION DATA:
- (1) diameter (inches) 2"
 - (2) total depth (feet) 210
 - (3) static water level (feet) 60 below ~~above~~ top of ground.
 - (4) casing pvc, 200,
(material) (depth)
(size) if telescope see back.
 - (5) screen 10, 200
(length) (depth to top)
12, pvc
(size) (material)
 - (6) pump 1, 650
(HP) (yield gpm)
Electric
(type power)
 - (7) electric log no
(yes or no)
 - (organization running log)
 - (8) how well bottom plugged sand
show

RECEIVED


JUN 16 1986

Department of Natural Resources
Bureau of Land & Water Resources

DRILLERS REMARKS:

If well telescopes please sketch and show depths.

GROUND LEVEL

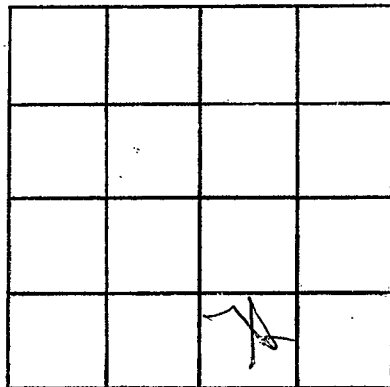

SECTION _____

Please indicate well location X.

ADDITIONAL INFORMATION

If more than one screen,
show locations of each on sketch.