

MISSISSIPPI DEPARTMENT OF NATURAL RESOURCES
Bureau of Land and Water Resources
 Southport Mall
 P.O. Box 10631
 Jackson, Mississippi 39209
WATER WELL DRILLERS LOG

<u>P. River</u>
<u>X side</u>

10/21 1988 Bud Penton Pearl River
 date well completed firm name county well located

LANDOWNER: Willie Beach
1907 Lyman Road
Wilcox Mills
 (mailing address)

description of formations encountered	from	to
<u>Red shale</u>	<u>0</u>	<u>15</u>
<u>white sand</u>	<u>15</u>	<u>20</u>
<u>Blue shale</u>	<u>20</u>	<u>150</u>
<u>Grey sand</u>	<u>150</u>	<u>183</u>

WELL LOCATION:
 sec. 4 T. 6 N. R. 16 E
 S W
2 miles East of Wilcox
 (distance) (direction) (nearest town)

WELL PURPOSE: none
 (home, irrigation, municipal, industrial)

- WELL COMPLETION DATA:
- (1) diameter (inches) 2"
 - (2) total depth (feet) 183
 - (3) static water level (feet) 60 below/above-top of ground.
 - (4) casing pvc, 183,
 (material) (depth)
 (size) if telescope see back.
 - (5) screen 10, 17.5
 (length) (depth to top)
1/2, pvc
 (size) (material)
 - (6) pump 1, 450
 (HP) (yield gpm)
Elect
 (type power)
 - (7) electric log no
 (yes or no)
 (organization running log)
 - (8) how well bottom plugged hard


RECEIVED
 NOV 15 1988

Department of Natural Resources
 Bureau of Land & Water Resources

DRILLERS REMARKS:

If well telescopes please sketch and show depths.

GROUND LEVEL

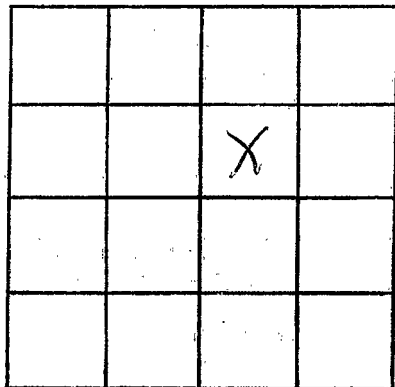

SECTION 4

Please indicate well location X.

ADDITIONAL INFORMATION

If more than one screen,
show locations of each on sketch.