

MISSISSIPPI DEPARTMENT OF NATURAL RESOURCES

Bureau of Land and Water Resources

Southport Mall

P.O. Box 10631

Jackson, Mississippi 39209

WATER WELL DRILLERS LOG

P. RIVER
~~X-161~~
 2124

8/13

1988 Bud Denton

Pearl River

date well completed

firm name

county well located

LANDOWNER: Mr. E. E. Egan
Jelly Stone Park Road
 (mailing address)

WELL LOCATION:
 sec. 9 T 6 N R 16 E
 S W
1 miles East of McComb
 (distance) (direction) (nearest town)

WELL PURPOSE: Home
 (home, irrigation, municipal, industrial)

- WELL COMPLETION DATA:
- (1) diameter (inches) 2"
 - (2) total depth (feet) 1066
 - (3) static water level (feet) 8 below above top of ground.
 - (4) casing PVC 1066,
 (material) (depth)
no if telescope see back.
 (size)
 - (5) screen 20 1046,
 (length) (depth to top)
12 PVC
 (size) (material)
 - (6) pump no (HP) (yield gpm)
 (type power)
 - (7) electric log no
 (yes or no)
 (organization running log)
 - (8) how well bottom plugged Sand
Shark

description of formations encountered	from	to
white shale	0	40
white sand	40	60
blue shale	60	230
blue sand	230	280
blue shale	280	400
gray sand	400	430
blue shale	430	1012
gray sand	1012	1066

UNABLE TO FIND OWNERS NAME

RECEIVED


NOV 15 1988

Department of Natural Resources
 Bureau of Land and Water Resources

DRILLERS REMARKS:

If well telescopes please sketch and show depths.

GROUND LEVEL

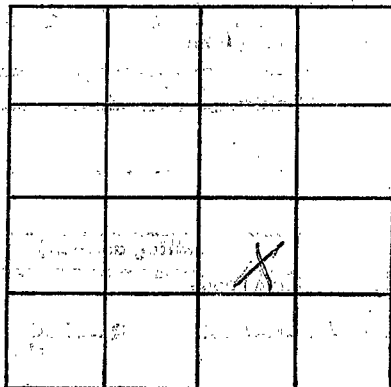

SECTION 9

Please indicate well location X.

ADDITIONAL INFORMATION

If more than one screen, show locations of each on sketch.