

MISSISSIPPI DEPARTMENT OF NATURAL RESOURCES

Bureau of Land and Water Resources

Southport Mall

P.O. Box 10631

Jackson, Mississippi 39209

WATER WELL DRILLERS LOG

PR. J. X 2528

9/20 1989 Bud Pentecost Pearl River
 date well completed firm name county well located


LANDOWNER: First Baptist Church Lagoyes Plu. Pilgrimage Miss.
 (mailing address)

description of formations encountered	from	to
white sand	0	20
white shale	20	30
white sand	30	64
Blue shale	64	370
Grey sand	370	400
black shale	400	735
gray sand	735	860
white shale	860	982
gray sand	982	1111

WELL LOCATION:
 sec. 18 T 6 N R. 16 E
2 miles East of Preppus
 (distance) (direction) (nearest town)

WELL PURPOSE: home
 (home, irrigation, municipal, industrial)

- WELL COMPLETION DATA:
- (1) diameter (inches) 2"
 - (2) total depth (feet) 1110
 - (3) static water level (feet) 4 below above top of ground.
 - (4) casing PCC 1110
 (material) (depth)
 (size) if telescope see back.
 - (5) screen _____
 (length) (depth to top)
 (size) (material)
 - (6) pump _____
 (HP) (yield gpm)
 (type power)
 - (7) electric log _____
 (yes or no)
 (organization running log)
 - (8) how well bottom plugged _____

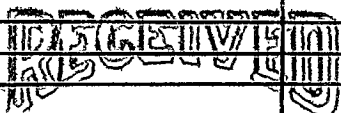


JAN 26 1990

Department of Natural Resources
 Bureau of Land & Water Resources

DRILLERS REMARKS:

If well telescopes please
sketch and show depths.

GROUND LEVEL

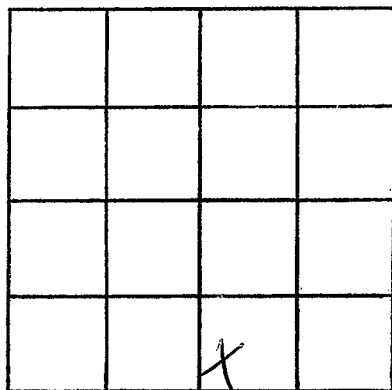

SECTION _____

Please indicate well location X.

ADDITIONAL INFORMATION

Lined area for additional information.

more than one screen,
show locations of each on sketch.