

MISSISSIPPI DEPARTMENT OF NATURAL RESOURCES

Bureau of Land and Water Resources

COUNTY WELL LOCATED - *Pearl River*
 WELL NUMBER *X* CODED
 DATE WELL COMPLETED *2/33*
6-3-90

PERMIT NUMBER **POUNCEY WATER WELLS**
 NAME OF DRILLING FIRM *10200 POSSUM FORK*
PICAYUNE, MS 39466

P.O. Box 10631
 Jackson, Mississippi 39209
 WATER WELL DRILLERS LOG

NAME & MAILING ADDRESS OF LANDOWNER
Jammy Holard
Doris Rd.
Rt. 1 Picayune MS
 WELL LOCATION: SEC *10* TOWNSHIP *6* RANGE *16*
E
W
 DISTANCE *14* Miles *E* DIRECTION of *Evans* NEAREST TOWN *Evans*
 OTHER LANDMARK *Next to Lost Place on Doris Rd.*
 WELL PURPOSE (Home, Irrigation, Municipal, Industrial, Fish Pond, etc.)

PUMP DATA
 PUMP TYPE (Circle One): Submersible, Turbine, Jet, Flowing Well, Other (Describe) _____
 POWER TYPE (Circle One): Electric, Tractor, Diesel, Gasoline, Butane, Other (Describe) *7/2 H/P Solar*
 Pump Capacity (GPM) *12* No. of Stages *5* Setting Depth *60* FT.
 PUMP TEST
 Well yielded *22* GPM with a drawdown of _____ ft. after _____ hours of pumping

WELL DATA
 Well Depth *631* Casing Diameter (In.) ~~4"~~ *4"* Casing Length (Ft.) *621*
 Type of Casing *PVC* Hole Depth *631* Depth to Static Water Level *33'*
 TYPE OF COMPLETION: (Circle One or More): Gravel Packed, Underreamed, Telescoped, Natural Development, Open Hole, Other (Describe) _____
 Top of Lap Pipe or Reduction in Casing *180* FEET IF TELESCOPED OR MORE THAN ONE SCREEN: USE BACK PAGE

LOG DATA
 TYPE OF LOG RUN (Circle One): No Log Run, Electric, Gamma Ray, Density, Sonic, Neutron, Other (Describe) _____
 Name of Organization Running Log

SCREEN DATA
 Diameter - Inches *2* Length - Feet *10* Slot Size - Inches *5-010*
5-012
 Screen Type *PVC wrap* Depth to Bottom - Feet *631*

GEOLOGIC DATA (Office Use Only)

Surface Elev.	Geologic Unit	Unit Thickness	Depth to Top
Subs. SWL	Date	Analysis	Aquifer Test

Driller's Remarks
Very good sd. to Pee-gravel-

DESCRIPTION OF FORMATIONS ENCOUNTERED	FROM	TO	FORMATIONS (Continued)	FROM	TO
<i>Top</i>	<i>0</i>	<i>17</i>	<i>St. S. fin.</i>	<i>600</i>	<i>619</i>
<i>Big Gravel</i>	<i>17</i>	<i>28</i>	<i>good sd.</i>		
<i>Blue Clay</i>	<i>28</i>	<i>354</i>			
<i>fine cut. St.</i>	<i>354</i>	<i>371</i>			
<i>Blue Shale</i>	<i>371</i>	<i>600</i>			

RECEIVED


JUN 11 1990

Department of Natural Resources
 Bureau of Land & Water Resources

IF MORE SPACE IS NEEDED, USE BACK

If well telescopes please sketch and show depths.

GROUND LEVEL

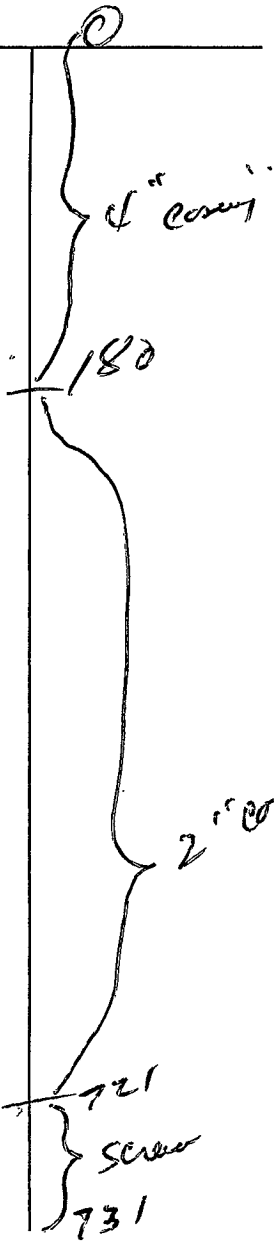

		*	

SECTION 10

Please indicate well location X.

ADDITIONAL INFORMATION

If more than one screen, show location of each on sketch.