

P. River
* 2135

MISSISSIPPI DEPARTMENT OF NATURAL RESOURCES
 Bureau of Land and Water Resources
 Southport Mall
 P.O. Box 10631
 Jackson, Mississippi 39209
WATER WELL DRILLERS LOG

9/17 1990 Budger Pearl River
 date well completed firm name county well located

LANDOWNER: Michael, Gerald
Amuel Rd.
 (mailing address)

WELL LOCATION:
 sec 20 T 16 N R 16 E
2 miles East pearl river
 (distance) (direction) (nearest town)

WELL PURPOSE: Home
 (home, irrigation, municipal, industrial)

- WELL COMPLETION DATA:
- (1) diameter (inches) 2'
 - (2) total depth (feet) 250
 - (3) static water level (feet) 18 below above top of ground.
 - (4) casing pvc 250
 (material) (depth)
 (size) If telescope see back.
 - (5) screen 10 245
 (length) (depth to top)
12 pvc
 (size) (material)
 - (6) pump 1/2 8
 (HP) (yield gpm)
Elect
 (type power)
 - (7) electric log NO
 (yes or no)
 (organization running log)
 - (8) how well bottom plugged Sand
shale

description of formations encountered	from	to
	<u>white shale</u>	<u>0</u>
<u>White sand</u>	<u>10</u>	<u>30</u>
<u>Blue shale</u>	<u>30</u>	<u>40</u>
<u>White sand</u>	<u>40</u>	<u>85</u>
<u>Blue shale</u>	<u>85</u>	<u>105</u>
<u>sand mound</u>	<u>105</u>	<u>147</u>
<u>Blue shale</u>	<u>147</u>	<u>190</u>
<u>gray sand</u>	<u>190</u>	<u>250</u>

RECEIVED
15


OCT 15 1990

Department of Natural Resources
 Bureau of Land & Water Resources

DRILLERS REMARKS:

If well telescopes please sketch and show depths.

GROUND LEVEL

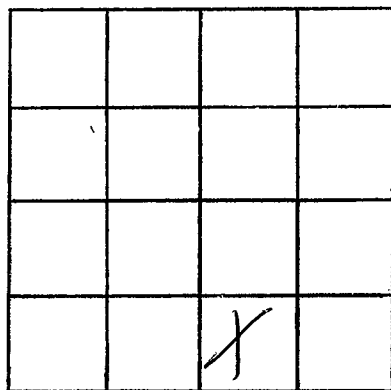

SECTION _____

Please indicate well location X.

ADDITIONAL INFORMATION

If more than one screen,
show locations of each on sketch.