

MISSISSIPPI DEPARTMENT OF NATURAL RESOURCES

Bureau of Land and Water Resources

Southport Mall

P.O. Box 10631

Jackson, Mississippi 39209

WATER WELL DRILLERS LOG

P. River
8/30

8/30
 date well completed

1990 Bud Per-ton
 firm name

Pearl River
 county well located

LANDOWNER: <u>M. Mendoza</u>	description of formations encountered	from	to
<u>P.O. Box 2</u>		<u>Red shale</u>	<u>0</u>
<u>Carroll Miss.</u> (mailing address)	<u>White sand gravel</u>	<u>15</u>	<u>73</u>
	<u>Blue shale</u>	<u>73</u>	<u>525</u>
	<u>Gray sand</u>	<u>525</u>	<u>599</u>

WELL LOCATION:
 sec. 5 T 6 N R 16 E
2 miles E of Proctor
 (distance) (direction) (nearest town)


WELL PURPOSE: home
 (home, irrigation, municipal, industrial)

- WELL COMPLETION DATA:
- (1) diameter (inches) 2
 - (2) total depth (feet) 599
 - (3) static water level (feet) 25 below top of ground.
 - (4) casing pvc 599
 (material) (depth)
 - (size) If telescope see back.
 - (5) screen 10 588
 (length) (depth to top)
 - (size) 12 (material) pvc
 - (6) pump 1/2 5
 (HP) (yield gpm)
 - (type power) Elect
 - (7) electric log no
 (yes or no)

(organization running log)

(8) how well bottom plugged standard
sherb

DRILLERS REMARKS:

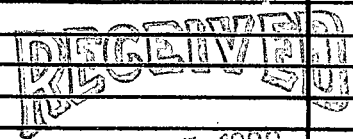


OCT 15 1990

Department of Natural Resources
 Bureau of Land and Water Resources

If well telescopes please sketch and show depths.

GROUND LEVEL

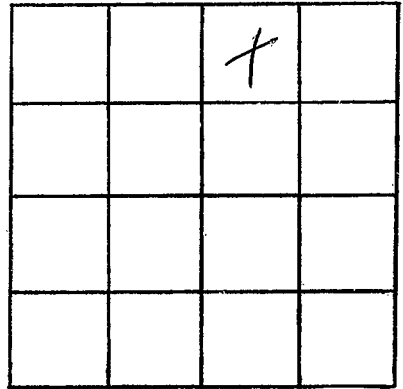

SECTION _____

Please indicate well location X.

ADDITIONAL INFORMATION

If more than one screen, show locations of each on sketch.