

MISSISSIPPI DEPARTMENT OF NATURAL RESOURCES

Bureau of Land and Water Resources

Southport Mall

P.O. Box 10631

Jackson, Mississippi 39209

WATER WELL DRILLERS LOG

P. RIVER
A 2143

9/18-90
date well completed

Red penton
firm name

Pearl River
county well located

LANDOWNER: Dolly penton
Sycamore pines Rd
(mailing address)

description of formations encountered

from to

Red shale	0	15
White sand	15	115
Blue shale	115	175
Blue sand	175	275
Blue shale	275	520
Gray sand	520	576

WELL LOCATION:

sec. 6 T. 6 N. R. 16 E
S. W.
2 miles East of Prequal
(distance) (direction) (nearest town)

WELL PURPOSE: home
(home, irrigation, municipal, industrial)

WELL COMPLETION DATA:

(1) diameter (inches) 2
(2) total depth (feet) 576
(3) static water level (feet) 30 below
top of ground. above

(4) casing pvc 576
(material) (depth)

(size) if telescope see back.

(5) screen 10 576
(length) (depth to top)

10 pvc
(size) (material)


(6) pump no
(HP) (yield gpm)

(type power)

(7) electric log no
(yes or no)

(organization running log)

(8) how well bottom plugged short

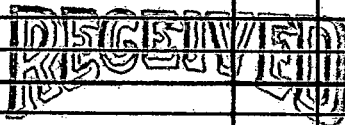


FEB 19 1991

Dept. of Environmental Quality
Bureau of Land & Water Resources

DRILLERS REMARKS:

If well telescopes please sketch and show depths.

GROUND LEVEL

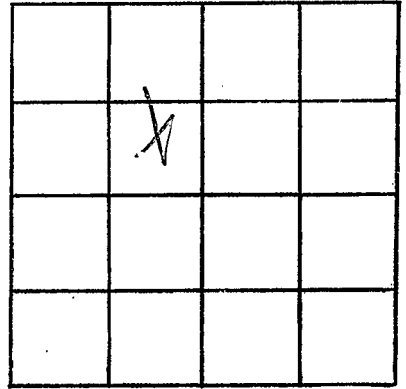

SECTION _____

Please indicate well location X.

ADDITIONAL INFORMATION

If more than one screen,
show locations of each on sketch.