

MISSISSIPPI DEPARTMENT OF NATURAL RESOURCES

Bureau of Land and Water Resources

Southport Mall

P.O. Box 10631

Jackson, Mississippi 39209

WATER WELL DRILLERS LOG

P. RIVER  
X 2142

#/ 10 19 21 Bud Penton Pearl River  
date well completed firm name county well located

LANDOWNER: Fred Magee  
2419 East Canal St.  
Piquette Miss.  
(mailing address)

WELL LOCATION:  
sec. 7 T. 42 N R. 16 E  
S W  
0 miles East Piquette  
(distance) (direction) (nearest town)

WELL PURPOSE: none  
(home, irrigation, municipal, industrial)

WELL COMPLETION DATA:

- (1) diameter (inches) 2
- (2) total depth (feet) 987
- (3) static water level (feet) 10 below above top of ground.
- (4) casing PVC 987  
(material) (depth)  
(size) if telescope see back.
- (5) screen 20 967  
(length) (depth to top)  
12 PVC  
(size) (material)
- (6) pump NO  
(HP) (yield gpm)  
(type power)
- (7) electric log NO  
(yes or no)  
(organization running log)
- (8) how well bottom plugged Sand  
Sharp

description of formations encountered	from	to
white shell	0	9
white sand	9	20
blue shale	20	30
white sand	30	53
blue shale	53	85
gray sand	85	125
blue shale	125	210
gray sand	210	253
blue shale	253	295
blue sand	295	357
blue shale	357	610
blue sand	610	635
blue shale	635	940
gray sand	940	987

RECEIVED


JUN 7 1991

Dept. of Environmental Quality  
Bureau of Land & Water Resources

DRILLERS REMARKS:

If well telescopes please sketch and show depths.

GROUND LEVEL

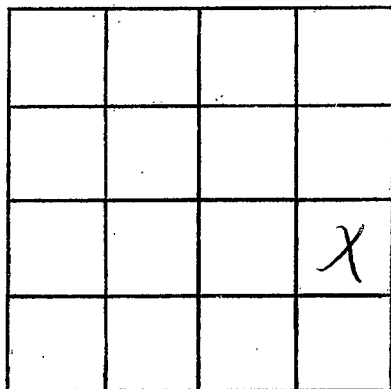

SECTION \_\_\_\_\_

Please indicate well location X.

ADDITIONAL INFORMATION

If more than one screen, show locations of each on sketch.