

MISSISSIPPI DEPARTMENT OF NATURAL RESOURCES

Bureau of Land and Water Resources


P.O. Box 10631
Jackson, Mississippi 39209
WATER WELL DRILLERS LOG

COUNTY WELL LOCATED <i>Pearl River</i>	
WELL NUMBER <i>A</i>	CODED
DATE WELL COMPLETED <i>4-20-92</i>	

PERMIT NUMBER
NAME OF DRILLING FIRM <i>Pouncey</i>

NAME & MAILING ADDRESS OF LANDOWNER <i>Donald Mitchell</i>			
<i>Hy 43</i>			
<i>Pt. 4 Pouncey</i>			
WELL LOCATION: SEC	TOWNSHIP	RANGE	
<i>15</i>	<i>6</i>	<i>16</i>	<i>(N S) (W E)</i>
DISTANCE <i>1.14</i> Miles	DIRECTION <i>East</i>	NEAREST TOWN <i>Salem</i>	
OTHER LANDMARK <i>old mitchell place</i>			
WELL PURPOSE <input type="checkbox"/> Home, <input type="checkbox"/> Irrigation, <input type="checkbox"/> Municipal, <input type="checkbox"/> Industrial, <input type="checkbox"/> Fish Pond, etc.			

PUMP DATA		
PUMP TYPE (Circle One): Submersible, Turbine, <u>Jet</u> Flowing Well, Other (Describe) _____		
POWER TYPE (Circle One): <u>Electric</u> Tractor, Diesel, Gasoline, Butane, Other (Describe) _____ H/P _____		
Pump Capacity (GPM) <i>12</i>	No. of Stages <i>2</i>	Setting Depth <i>46</i> FT.
PUMP TEST		
Well yielded <i>12</i> GPM with a drawdown of _____ ft. after _____ hours of pumping		

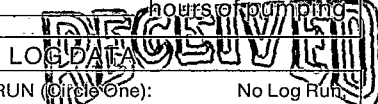

WELL DATA		
Well Depth <i>620</i>	Casing Diameter (In.) <i>2</i>	Casing Length (Ft.) <i>610</i>
Type of Casing <i>PVC</i>	Hole Depth <i>620</i>	Depth to Static Water Level <i>21'</i>
TYPE OF COMPLETION: (Circle One or More): <input checked="" type="checkbox"/> Gravel Packed, <input type="checkbox"/> Underreamed, <input type="checkbox"/> Telescoped, <input checked="" type="checkbox"/> Natural Development, <input type="checkbox"/> Open Hole, <input type="checkbox"/> Other (Describe) _____		
Top of Lap Pipe or Reduction in Casing FEET <input type="checkbox"/> IF TELESCOPED OR MORE THAN ONE SCREEN: USE BACK PAGE		

LOG DATA	
TYPE OF LOG RUN (Circle One): No Log Run, Electric, Gamma Ray, Density, Sonic, Neutron, Other (Describe) _____	
<i>MAY 29 1992</i>	
Name of Organization Running Log	

SCREEN DATA		
Diameter - Inches <i>2</i>	Length - Feet <i>10</i>	Slot Size - Inches <i>108</i>
Screen Type <i>PVC wrap</i>		Depth to Bottom - Feet <i>620</i>

GEOLOGIC DATA (Office Use Only)			
Surface Elev.	Geologic Unit	Unit Thickness	Depth to Top
Subs. SWL	Date	Analysis	Acquifer Test
Driller's Remarks <i>very fine sd.</i>			

DESCRIPTION OF FORMATIONS ENCOUNTERED	FROM	TO	FORMATIONS (Continued)	FROM	TO
<i>TOP</i>	<i>0</i>	<i>8</i>	<i>hd shell</i>	<i>196</i>	<i>468</i>
<i>sd.</i>	<i>8</i>	<i>48</i>	<i>set to very fine</i>	<i>468</i>	<i>490</i>
<i>hd wt clay</i>	<i>48</i>	<i>56</i>	<i>hd hd shell</i>	<i>490</i>	<i>588</i>
<i>sd good shallow clay</i>	<i>36</i>	<i>68</i>	<i>set to 1/2 to 2/3 fine mix</i>	<i>588</i>	<i>620</i>
<i>clay</i>	<i>68</i>	<i>176</i>			
<i>sd to 3' decant</i>	<i>176</i>	<i>196</i>			

IF MORE SPACE IS NEEDED, USE BACK

SOURCES
STAGES

If well telescopes please sketch and show depths.

GROUND LEVEL

SECTION _____

Please indicate well location X.

ADDITIONAL INFORMATION

If more than one screen,
show location of each on sketch.