

P. RIVER
 X 2161

MISSISSIPPI DEPARTMENT OF NATURAL RESOURCES
 Bureau of Land and Water Resources
 Southport Mall
 P.O. Box 10631
 Jackson, Mississippi 39209
WATER WELL DRILLERS LOG

11-9 1992 Bud Penton Water Well Pearl River
 date well completed firm name county well located


LANDOWNER: Bobby Jarrell
 60 Rolling Oaks
 Picayune MS 39466
 (mailing address)

description of formations encountered	from	to
	white clay	0
white sand	29	50
blue clay	50	210
gray sand	210	310

WELL LOCATION:
 sec. 17 T. 6 N. R. 16 E.
 S W
 2 miles E of Picayune
 (distance) (direction) (nearest town)

WELL PURPOSE: Home
 (home, irrigation, municipal, industrial)

- WELL COMPLETION DATA:
- (1) diameter (inches) 5
 - (2) total depth (feet) 310
 - (3) static water level (feet) 45 below top of ground.
 - (4) casing PVC, 300 (material), (depth)
 2 (size) if telescope see back.
 - (5) screen 10, 300 (length), (depth to top)
 2, PVC (size), (material)
 - (6) pump 1, 15 (HP), (yield gpm)
 elec (type power)
 - (7) electric log NO (yes or no)
 (organization running log)
 - (8) how well bottom plugged sandshank

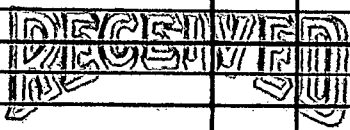


DEC 10 1992

Dept. of Environmental Quality
 Bureau of Land & Water Resources

DRILLERS REMARKS:

If well telescopes please sketch and show depths.

GROUND LEVEL

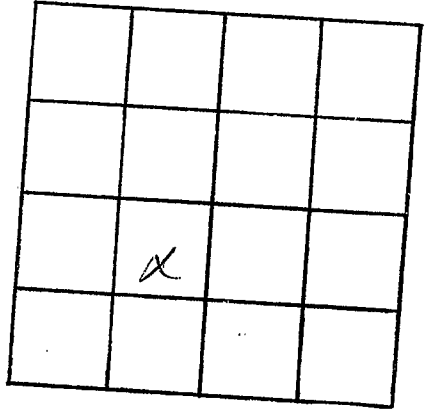

SECTION 17

Please indicate well location X.

ADDITIONAL INFORMATION

If more than one screen,
show locations of each on sketch.