

MISSISSIPPI DEPARTMENT OF ENVIRONMENTAL QUALITY

Office of Land and Water Resources

P. O. Box 10631
Jackson, MS 39289-0631
WATER WELL DRILLERS LOG

COUNTY WELL LOCATED <i>Pearl River</i>	
WELL NUMBER <i>X 2165</i>	CODED
DATE WELL COMPLETED <i>6-8-93</i>	

PERMIT NUMBER
NAME OF DRILLING FIRM <i>Bud Penton & Sons</i>
<i>Water Well Service</i>

NAME & MAILING ADDRESS OF LANDOWNER <i>WILLIAM SNYDER</i>		
<i>513 Richardson Rd</i>		
<i>Picayune Ms 39466</i>		
WELL LOCATION: SEC	TOWNSHIP	RANGE
<i>19</i>	<i>6</i>	<i>N 16 E</i>
DISTANCE	DIRECTION	NEAREST TOWN
<i>3</i> Miles	<i>N</i>	of <i>Picayune</i>
OTHER LANDMARK		
WELL PURPOSE: Home, Irrigation, Municipal, Industrial, Fish Pond, etc. <i>Home</i>		

PUMP DATA			
PUMP TYPE (Circle One): <input checked="" type="radio"/> Submersible Turbine, Jet Flowing Well, Other (Describe) _____			
POWER TYPE (Circle One): Electric, Tractor, Diesel, Gasoline, Butane, Other (Describe) _____ H/P <i>12</i>			
Pump Capacity (GPM) <i>20</i>	No. of Stages <i>5</i>	Setting Depth <i>40</i>	FT.
PUMP TEST			
Well yielded _____ GPM with a drawdown of _____ ft. after _____ hours of pumping			

WELL DATA		
Well Depth <i>335</i>	Casing Diameter (In.) <i>4" x 2"</i>	Casing Length (Ft.) <i>325</i>
Type of Casing <i>PVC</i>	Hole Depth <i>335</i>	Depth to Static Water Level <i>15</i>

LOG DATA	
TYPE OF LOG RUN (Circle One): Electric, Gamma Ray, Density, Sonic, Neutron, Other (Describe) _____	
Name of Organization Running Log <i>No Log Run</i>	

TYPE OF COMPLETION: (Circle One or More): <input checked="" type="checkbox"/> Gravel Packed, <input type="checkbox"/> Underreamed, <input type="checkbox"/> Telescoped, <input checked="" type="checkbox"/> Natural Development, <input type="checkbox"/> Open Hole, <input type="checkbox"/> Other (Describe) _____			
WELL GROUTED TO A DEPTH OF <u><i>10</i></u> FEET Type Grout (circle one): Cement, Bentonite, or Mix			

GEOLOGIC DATA (Office Use Only)			
Surface Elev.	Geologic Unit	Unit Thickness	Depth to Top
Subs. SWL	Date	Analysis	Aquifer Test
Driller's Remarks			

SCREEN DATA		
Diameter - Inches <i>2</i>	Length - Feet <i>10</i>	Slot Size - Inches <i>.010</i>
Screen Type <i>PVC</i>	Depth to Bottom - Feet <i>335</i>	

DESCRIPTION OF FORMATIONS ENCOUNTERED	FROM	TO	FORMATIONS (Continued)	
			FROM	TO
<i>White clay</i>	<i>0</i>	<i>15</i>		
<i>White sand</i>	<i>15</i>	<i>105</i>		
<i>Blue clay</i>	<i>105</i>	<i>270</i>		
<i>Gray sand</i>	<i>270</i>	<i>335</i>		


RECEIVED
JUN 28 1993

Dept. of Environmental Quality
Office of Land & Water Resources

IF MORE SPACE IS NEEDED, USE BACK

If well telescopes please
sketch and show depths.

GROUND LEVEL

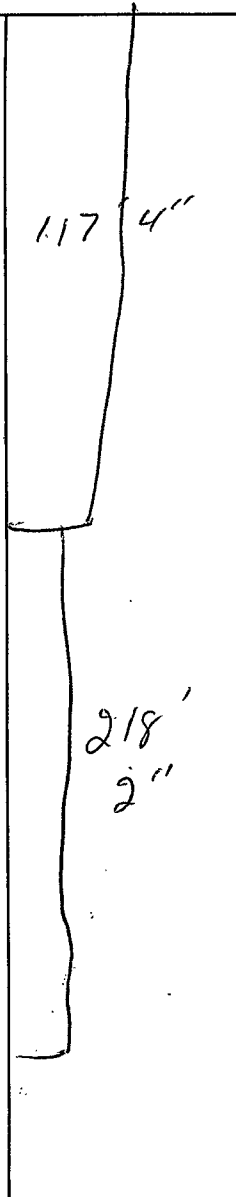

		X	

SECTION 19

Please indicate well location X.

ADDITIONAL INFORMATION

If more than one screen,
show location of each on sketch.