

MISSISSIPPI  
BOARD OF WATER COMMISSIONERS  
416 North State Street  
Jackson, Mississippi 39201

**WATER WELL DRILLERS LOG**

3/67  
date well completed

19 STAR DRILLING SERVICE  
firm name

PERRY  
county well located

LANDOWNER: AT ROGERS

PUMPING STATION Rd.  
RUNNELTOWN, MISSISSIPPI  
(mailing address)

WELL LOCATION:

sec 8 T 5 N R 11 E  
S W  
2 1/2 miles N of RUNNELTOWN  
(distance) (direction) (nearest town)

WELL PURPOSE: Home  
(home, irrigation, municipal, industrial)

WELL COMPLETION DATA:

- (1) diameter (inches) 2"
- (2) total depth (feet) 95'
- (3) static water level (feet) 38' below  
top of ground. above
- (4) casing plastic, 90',  
(material) (depth)  
2" if telescope see back.  
(size)
- (5) screen 5', 90'  
(length) (depth to top)  
D/O 2", plastic  
(size) (material)
- (6) pump 1 12  
(HP) (yield gpm)  
Flgc  
(type power)
- (7) electric log NO  
(yes or no)  
(organization running log)
- (8) how well bottom plugged VALVE


description of formations encountered

|                                | from      | to        |
|--------------------------------|-----------|-----------|
| <u>SURFACE</u>                 | <u>0</u>  | <u>12</u> |
| <u>Blue + WHITE CLAY</u>       | <u>12</u> | <u>31</u> |
| <u>Brown + WHITE CLAY</u>      | <u>31</u> | <u>53</u> |
| <u>Blue CLAY + SAND STRIPS</u> | <u>53</u> | <u>72</u> |
| <u>FINE BLUE SAND</u>          | <u>72</u> | <u>86</u> |
| <u>COARSE W.B. SAND</u>        | <u>86</u> | <u>95</u> |

DRILLERS REMARKS:

If well telescopes please sketch and show depths.

GROUND LEVEL

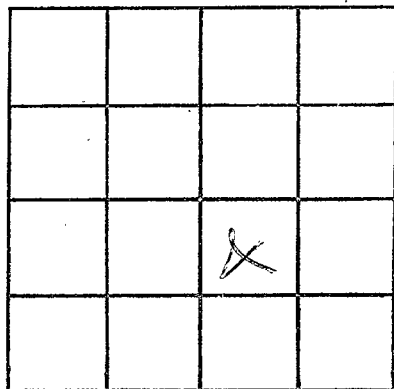

SECTION 4

Please indicate well location X.

ADDITIONAL INFORMATION

If more than one screen, show locations of each on sketch.