

PERRY
A 15

MISSISSIPPI BOARD OF WATER COMMISSIONERS

CODED

12-6-62

WATER WELL DRILLERS LOG

Date: 12-6, 1962, Driller: M. N. Moore ^{SR} County Perry
430/9 RT 2 (Name Hattiesburg)

(1) Owner of Land: J. C. Courtney
(Name)
Hattiesburg Miss RT 2
(Address)

(2) Location: 1/4, 1/4, Sec. 7 T5 R11,
2 miles West of Rollingstone
(distance) (direction) (Nearest Town)

(3) Topography: _____
(Hilly) (Flat) (Level)

(4) Purpose of Well: DRINKING
(Domestic Irrigation
Municipal, Industrial, Other)

Description & Color of Materials Sand, Clay, Red Clay, Shell, etc.	Thick- ness Feet	Depth Feet
Surface	0	8
Sand + Gravel	8	26
Clay + Sandstone	26	47
Gravel	47	57
Gravel	57	74
Sand + Gravel	74	82
Big Rock 15 10		
Sandstone + clay	82	198
Sand. Shell	198	310

Information upon completion of well:

(1) Diameter _____ inches.

(2) Total Depth 310 feet.

(3) Water Level 6 feet below top of ground.

(4) Cased to 304, Size 2"


(5) Screen: Size 2", Length 6

(6) Were any formations sealed against pollution?
_____ yes, _____ no.

If YES depth of formation _____
Why _____

Drillers Remarks: _____

CODED

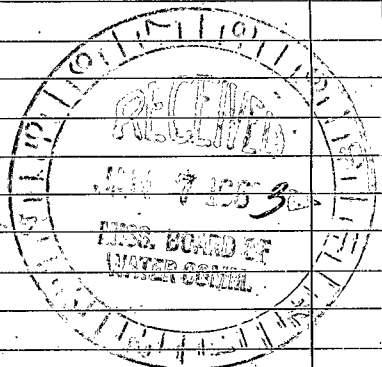

(Use Back Side)

Well No. 50

