

PERRY  
A17

WATER WELL DRILLERS LOG

**CODED**

8-20-62

Date: 8-20, 1962, Driller: M. W. Moore County Perry

45720

(Name)

(1) Owner of Land: Summie White

Description & Color of Materials  
Sand, Clay, Red Clay, Shell, etc.

Thick-  
ness  
Feet

Depth  
Feet

(Name)  
R T S. Reckton Miss

(Address)

(2) Location: 1/4, 1/4, Sec. 25 T 5 R 11

Surface 0 8.  
Sand Dry 8 14  
Clay 14 29  
Sand crystalline 29 40

0 miles, of DRY  
(distance) (direction) (Nearest Town)

(3) Topography: \_\_\_\_\_  
(Hilly) (Flat) (Level)

(4) Purpose of Well: water  
(Domestic Irrigation  
Municipal, Industrial, Other)

Information upon completion of well:

(1) Diameter 2 inches.

(2) Total Depth 40 feet.

(3) Water level 38 feet below top of ground.

(4) Cased to \_\_\_\_\_, Size \_\_\_\_\_

(5) Screen: Size 2, Length 4

(6) Were any formations sealed against pollution?

\_\_\_\_\_ yes, \_\_\_\_\_ no.


If YES depth of formation \_\_\_\_\_

Why \_\_\_\_\_

Drillers Remarks: \_\_\_\_\_

Wash out most matter  
to keep up pump.

**CODED**

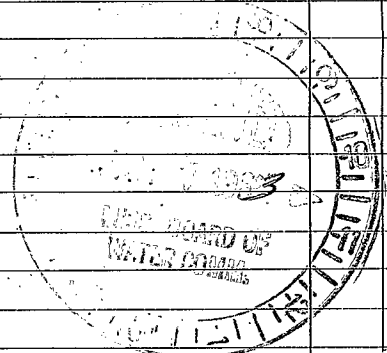

3

Well No.

(Use Back Side)

