

PERRY
A 18

MISSISSIPPI BOARD OF WATER COMMISSIONERS

11-3-63

WATER WELL DRILLERS LOG

CODED

Date: 11-3, 1963, Driller: H. W. McCarroll County Perry
445/1 (Name)

(1) Owner of Land: Alton Davis
(Name)
Hattiesburg Miss 1772
(Address)

Description & Color of Materials
Sand, Clay, Red Clay, Shell, etc.

Thick-
ness
Feet

Depth
Feet

Surface 0 17
Sand & Gravel 17 24

(2) Location: _____ 1/4, _____ 1/4, Sec. 20 T5 R11,
_____ miles _____, of Perry
(distance) (direction) (Nearest Town)


(3) Topography: _____
(Hilly) (Flat) (Level)

(4) Purpose of Well: House use
(Domestic Irrigation
Municipal, Industrial, Other)

Information upon completion of well:

- (1) Diameter 1 1/4 inches.
- (2) Total Depth 24 feet.
- (3) Water Level 17 feet below top of ground.
- (4) Cased to 14, Size 1 1/4.
- (5) Screen: Size 1 1/4, Length 3'.
- (6) Were any formations sealed against pollution?
_____ yes, _____ no.

CODED

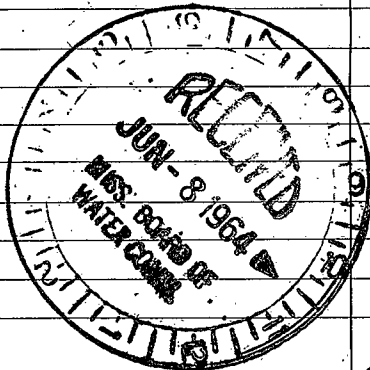

(Use Back Side)

Well No. 99

