

PERRY
A19

MISSISSIPPI BOARD OF WATER COMMISSIONERS

11-5-63

WATER WELL DRILLERS LOG

CODED

Date: 11-5, 1963, Driller: J. W. Moore County Perry
945/16 (Name)


(1) Owner of Land:	Description & Color of Materials Sand, Clay, Red Clay, Shell, etc.	Thick- ness Feet	Depth Feet
(Name) <u>TED Lewis</u> (Address) <u>Natchezburg Miss RT 2</u>	<u>Surface 0</u> <u>Sand 6</u>	<u>6</u> <u>23</u>	
(2) Location: _____ 1/4, _____ 1/4, Sec. <u>20 T5 R11</u> , _____ miles _____, of <u>ROBERTSTOWN</u> (distance) (direction) (Nearest Town)			
(3) Topography: _____ (Hilly) (Flat) (Level)			
(4) Purpose of Well: _____ (Domestic Irrigation Municipal, Industrial, Other)			

Information upon completion of well:

- (1) Diameter 1 1/4 inches.
- (2) Total Depth 23 feet.
- (3) Water Level 10 feet below top of ground.
- (4) Cased to 20, Size 1 1/4.
- (5) Screen: Size 1 1/4, Length 3'.
- (6) Were any formations sealed against pollution?
 _____ yes, _____ no.

If YES depth of formation _____
 Why _____
 Drillers Remarks: _____

CODED

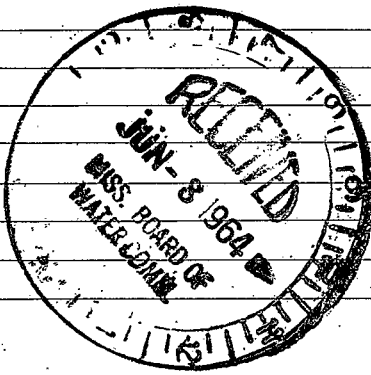

(Use Back Side)

30

Well No.

