

**MISSISSIPPI
BOARD OF WATER COMMISSIONERS**
416 North State Street
Jackson, Mississippi 39201

WATER WELL DRILLERS LOG

PERRY
A 22
5-68

5-2-68 19 Leaman Thomas Perry
date well completed firm name county well located


LANDOWNER:	description of formations encountered	from	to
RT 3			
<u>Richter, Miss</u> (mailing address)	<u>Chalk</u>	<u>0</u>	<u>378</u>
	<u>Sand</u>	<u>378</u>	<u>390</u>
WELL LOCATION:			
sec <u>36 T 5 N R 11 E</u>			
<u>3</u> miles <u>east</u> of <u>Remondis</u>			
(distance) (direction) (nearest town)			
WELL PURPOSE:			
<u>None</u> (home, irrigation, municipal, industrial)			
WELL COMPLETION DATA:			
(1) diameter (inches) <u>2"</u>			
(2) total depth (feet) <u>390</u>			
(3) static water level (feet) <u>flows</u> below top of ground.			
(4) casing <u>galv.</u> <u>385'</u> (material) (depth)			
<u> </u> if telescope see back. (size)			
(5) screen <u>2" 5'</u> (length) (depth to top)			
<u>8000</u> <u>Brass</u> (size) (material)			
(6) pump <u>1</u> <u>gal per min</u> (HP) (yield gpm) <u>6 sec</u>			
<u>110</u> (type power)			
(7) electric log <u>no</u> (yes or no)			
<u> </u> (organization running log)			
(8) how well bottom plugged <u>B. Wash Valve</u>			
DRILLERS REMARKS:			
<u>See other side</u>			

MAY 13 1968

MISS. DD. OF
WATER COMMISSIONERS

If well telescopes please sketch and show depths.

GROUND LEVEL

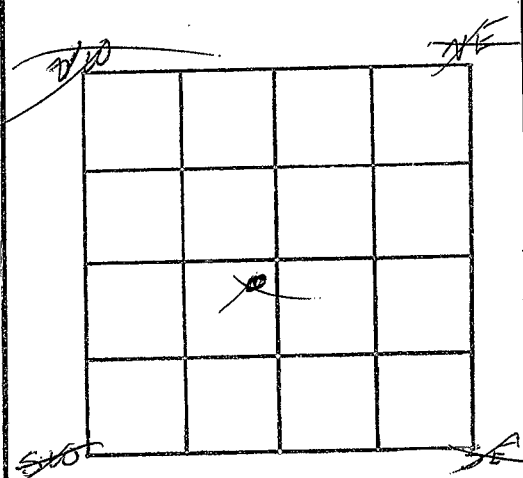

SECTION 36

Please indicate well location X.

ADDITIONAL INFORMATION

This well was drilled to 543' set in good sand well flowed but wouldn't clear water sands like previously mud but pump on well + pump 72 hrs didn't help. Well was drilled approx 15 years ago. If you have any information on that well S.T. please reach to me. Thank you

Lewis
[Signature]

If more than one screen, show locations of each on sketch.