

MISSISSIPPI BOARD OF WATER COMMISSIONERS

PERRY
AIAZ3
7-21-60

WATER WELL DRILLERS

CODED

Perry Co.
Perry

Date: July 21, 1960, Driller: DAVID NEWELL & SON, County: Perry

(Name)

A GRID

(1) Owner of Land: H.V. SHOEMAKE
(Name)

RFD #1 OVERT, MISS.
(Address)

(2) Location: SW 1/4 Sec. 1 T5 R1E
4 1/2 miles N.E. of Russellston
(distance) (direction) (Nearest Town)

(3) Topography: HILLY
(Hilly) (Flat) (Level)

(4) Purpose of Well:
(Domestic Irrigation
Municipal, Industrial, Other)

Description & Color of Materials
Sand, Clay, Red Clay, Shell, etc.


Thick-
ness
Feet

Depth
Feet

CLAY
SAND

0-30
30-50

CODED

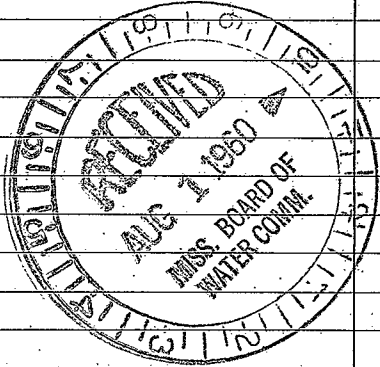

Information upon completion of well:

(1) Diameter 4 1/2 inches.

(2) Total Depth 50 feet.

(3) Water Level 35 feet below top of ground.

(4) Cased to 44, Size 2 in.

(5) Screen: Size 2 in., Length 6.

(6) Were any formations sealed against pollution?

✓ yes, _____ no.

If YES depth of formation 30 ft pipe CLAY

Why

Drillers Remarks:

Well No.

(Use Back Side)

322520 N 870300

