

MISSISSIPPI BOARD OF WATER COMMISSIONERS

WATER WELL DRILLERS LOG

Perry  
A24  
8/66

30  
Perry

Date: Aug. 18, 1966, Driller: S & R Drilling Service County: Forest  
(Name)

(1) Owner of Land:	Description & Color of Materials Sand, Clay, Red Clay, Shell, etc.	Thick- ness Feet	Depth- Feet
<u>M. P. Wigley</u> (Name)	<u>Sandy Clay</u>	<u>0</u>	<u>10</u>
<u>Route 2, Hattisburg, Miss.</u> (Address)	<u>Sand</u>	<u>10</u>	<u>20</u>
(2) Location: <u>N.E. 1/4, SE 1/4, Sec. 31 T. 5R. 11</u>	<u>Clay</u>	<u>20</u>	<u>30</u>
<u>1/2</u> miles <u>East</u> of <u>Hattisburg</u> (distance) (direction) (Nearest Town)	<u>Blue Clay</u>	<u>30</u>	<u>60</u>
(3) Topography: <u>Hilly</u> (Hilly) (Flat) (Level)	<u>Red &amp; white sand</u>	<u>60</u>	<u>85</u>
(4) Purpose of Well: <u>Home</u> (Domestic Irrigation Municipal, Industrial, Other)			


Information upon completion of well:

- (1) Diameter 2 inches.
- (2) Total Depth 85 feet.
- (3) Water Level 78 feet below top of ground.
- (4) Cased to 80, Size 2 in.
- (5) Screen: Size 2 in, Length 5 ft.
- (6) Were any formations sealed against pollution?  
 yes,  no.

If YES depth of formation \_\_\_\_\_

Why \_\_\_\_\_

Drillers Remarks: \_\_\_\_\_

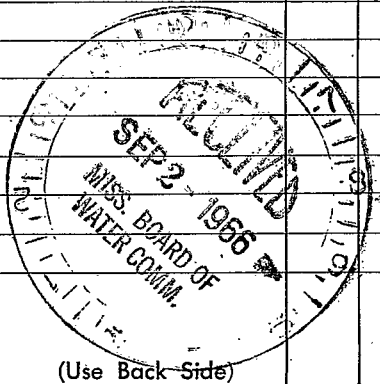

(Use Back Side)

Well No.

