

Perry
 A 25
 9-10-68

MISSISSIPPI
 BOARD OF WATER COMMISSIONERS
 416 North State Street
 Jackson, Mississippi 39201

CODED

WATER WELL DRILLERS LOG

Sep. 10. 19 *68* *Time Drilling Co* *Perry*
 date well completed firm name county well located

LANDOWNER: *L. Pitts*

description of formations encountered	from	to
	0	8
<i>fine clay</i>	8	11
<i>clay gray</i>	11	40
<i>sand fine</i>	40	44
<i>clay blue</i>	44	120
<i>sand fine</i>	120	128
<i>clay blue</i>	128	140
<i>sand</i>	140	165

Ellisville Miss
 (mailing address)


WELL LOCATION:
 sec. *3* T. *5* N. R. *11* E.
4 miles *N-NE* of *Rumrider*
 (distance) (direction) (nearest town)

WELL PURPOSE:
 (home, irrigation, municipal, industrial)

- WELL COMPLETION DATA:
- (1) diameter (inches) 2
 - (2) total depth (feet) 165
 - (3) static water level (feet) 50 ^{below} _{above} top of ground.
 - (4) casing PVC 160
 (material) (depth)
 - (size) if telescope see back.
 - (5) screen 5 160
 (length) (depth to top)
 - 2 Ruby
 (size) (material)
 - (6) pump 1 5
 (HP) (yield gpm)
 - Ele.
 (type power)
 - (7) electric log No
 (yes or no)

CODED

(organization running log)
 (8) how well bottom plugged Valley

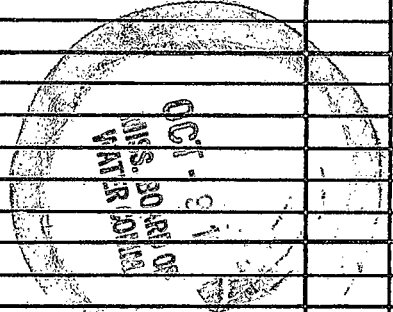


DRILLERS REMARKS:

165

If well telescopes please sketch and show depths.

GROUND LEVEL

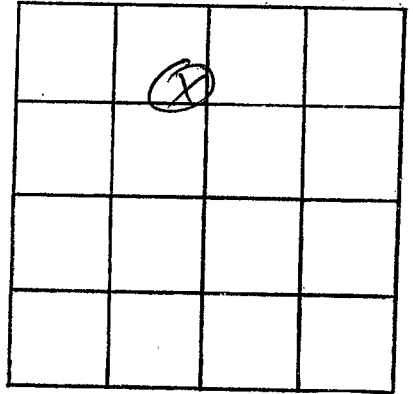

SECTION 3

Please indicate well location X.

ADDITIONAL INFORMATION

If more than one screen,
show locations of each on sketch.