

Perry  
A 26  
11-69  
USGS

MISSISSIPPI  
BOARD OF WATER COMMISSIONERS  
416 North State Street  
Jackson, Mississippi 39201

CODED

WATER WELL DRILLERS LOG

Nov 1969 date well completed      S & R firm name      Perry county well located

LANDOWNER: Mike Sanford  
Rumelatawa, Miss (mailing address)

WELL LOCATION:  
sec. 27 T. 5 N R. 11 E S W  
1 1/2 miles E of Rumelatawa (distance) (direction) (nearest town)

WELL PURPOSE: Home (home, irrigation, municipal, industrial)

- WELL COMPLETION DATA:
- (1) diameter (inches) 2"
  - (2) total depth (feet) 565
  - (3) static water level (feet) 106 below above top of ground.
  - (4) casing plastic 555 (material) (depth) 2" (size) if telescope see back.
  - (5) screen 10ft 555 (length) (depth to top) 2" plastic (size) (material)
  - (6) pump (HP) (yield gpm) (type power)
  - (7) electric log Yes (yes or no) (organization running log)
  - (8) how well bottom plugged Valve.

description of formations encountered	from	to
Sandy Clay	0	6
White Sand	6	14
White Clay	14	46
Blue Clay	46	68
Black Brown Clay	68	160
Fine Sand	160	172
Hard Clay	172	184
Shell + Sand Shays	184	440
Fine Sand	440	462
Shell Shays	462	547
White Sand	547	565
Shell + Sand	565	575
Shell (brown)	575	612

575-612 Cut like Sand but never get nothing but Shell and Brown Shell and take water like Sand.


Rumelatawa  
I had to hole on this job and didn't make a well due to trying plastic pipe, a well can be made at 565 with steel pipe

DRILLERS REMARKS:

MISS. ST. DEPT. OF WATER CONTROL

If well telescopes please sketch and show depths.

GROUND LEVEL

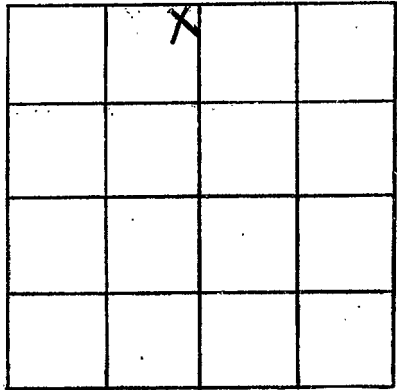

SECTION 27

Please indicate well location X.

ADDITIONAL INFORMATION

If more than one screen,  
show locations of each on sketch.