

Perry
A 27
8-13-69

MISSISSIPPI
 BOARD OF WATER COMMISSIONERS
 416 North State Street
 Jackson, Mississippi 39201

CODED

WATER WELL DRILLERS LOG

8/13 1969 SFR Perry
 date well completed firm name county well located

LANDOWNER: Leroy Hunter
Russellton, Miss
 (mailing address)

description of formations encountered	from	to
<u>Red + white</u>	<u>0</u>	<u>14</u>
<u>white clay</u>	<u>14</u>	<u>28</u>
<u>blue clay</u>	<u>28</u>	<u>48</u>
<u>Fine sand</u>	<u>48</u>	<u>55</u>
<u>blue clay</u>	<u>55</u>	<u>78</u>

WELL LOCATION:
 sec. 17 T. 5 N ✓ S R. 11 E W
2 miles N of Russellton
 (distance) (direction) (nearest town)

WELL PURPOSE: Home
 (home, irrigation, municipal, industrial)

- WELL COMPLETION DATA:
- (1) diameter (inches) 4"
 - (2) total depth (feet) 55
 - (3) static water level (feet) 29 below above top of ground.
 - (4) casing plastic, 50,
 (material) (depth)
4" if telescope see back.
 (size)
 - (5) screen 4", 50
 (length) (depth to top)
4" (size) plastic (material)
 - (6) pump 1/3 360 g.p.m.
 (HP) (yield gpm)
Sub.
 (type power)
 - (7) electric log _____
 (yes or no)
 (organization running log)
 - (8) how well bottom plugged Value


DRILLERS REMARKS:
Small Packed

SEP 20 1969

MISS. ED. OF
 WATER COM.

If well telescopes please sketch and show depths.

GROUND LEVEL

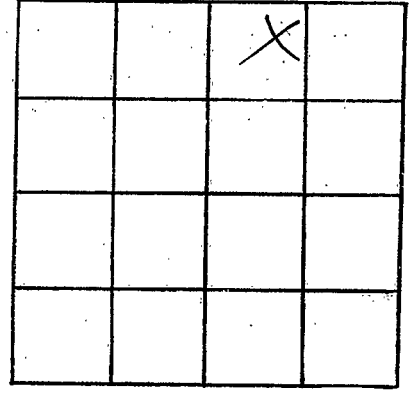

SECTION 17

Please indicate well location X.

ADDITIONAL INFORMATION

If more than one screen, show locations of each on sketch.