

CODED
CODED

Perry
A 28
12-13-69

MISSISSIPPI
BOARD OF WATER COMMISSIONERS
416 North State Street
Jackson, Mississippi 39201

WATER WELL DRILLERS LOG

12-13 1969 SHR Perry
date well completed firm name county well located

LANDOWNER: <u>Mr. O. L. Carr</u>	description of formations encountered	from	to
<u>Russelltown, Miss</u> (mailing address)			
WELL LOCATION: sec. <u>7</u> T <u>5</u> N R <u>11</u> E S W	<u>Sandy Clay</u>	<u>0</u>	<u>10</u>
<u>3</u> miles <u>N</u> of <u>Russelltown</u> (distance) (direction) (nearest town)	<u>Fine Sand</u>	<u>10</u>	<u>17</u>
WELL PURPOSE: <u>Home</u> (home, irrigation, municipal, industrial)	<u>Coarse Sand + Sand Rock</u>	<u>17</u>	<u>19</u>
WELL COMPLETION DATA:	<u>White Clay</u>	<u>19</u>	<u>34</u>
(1) diameter (inches) <u>2"</u>	<u>Red Clay</u>	<u>34</u>	<u>69</u>
(2) total depth (feet) <u>310</u>	<u>Rock</u>	<u>69</u>	<u>76</u>
(3) static water level (feet) <u>18</u> below above top of ground.	<u>Blue Clay</u>	<u>76</u>	<u>120</u>
(4) casing <u>plastic, 300 ft</u> (material) (depth)	<u>Blue Sand</u>	<u>120</u>	<u>176</u>
<u>2"</u> (size) if telescope see back.	<u>Sand</u>	<u>176</u>	<u>179</u>
(5) screen <u>10 ft, 300 ft</u> (length) (depth to top)	<u>Shell + Sand</u>	<u>179</u>	<u>207</u>
<u>2"</u> (size) <u>plastic</u> (material)	<u>Fine Sand</u>	<u>207</u>	<u>258</u>
(6) pump <u>1/2</u> <u>220 gpm</u> (HP) (yield gpm)	<u>Clay</u>	<u>258</u>	<u>259</u>
<u>plastic</u> (type power)	<u>Fine Sand</u>	<u>259</u>	<u>283</u>
(7) electric log _____ (yes or no)	<u>C.W.B. Sand</u>	<u>283</u>	<u>310</u>
(organization running log)			
(8) how well bottom plugged <u>U.C.</u>			

lost circulation
at 310-312 in
C.W.B. Sand + Black
of gravel


DEC 23 1969

MISS. Bd. OF
WATER COMMISSIONERS

DRILLERS REMARKS:

If well telescopes please sketch and show depths.

GROUND LEVEL

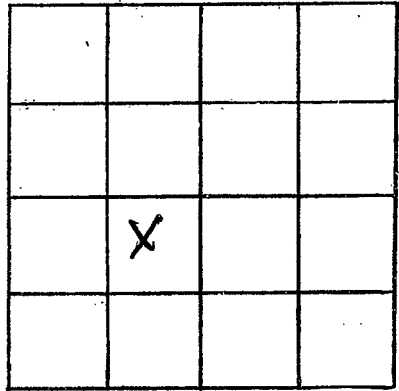

SECTION 7

Please indicate well location X.

ADDITIONAL INFORMATION

If more than one screen, show locations of each on sketch.