

Perry Co

A 29

12-23-69

MISSISSIPPI BOARD OF WATER COMMISSIONERS
416 North State Street
Jackson, Mississippi 39201

CODED

WATER WELL DRILLERS LOG

Dec 23, 1969 date well completed
Cochran & Rayb Dg. Ser firm name
Perry county well located

LANDOWNER:

A. A. Harvey
Route 2 Hattiesburg Miss
(mailing address)

description of formations encountered

from to

Red Sand	0	8
Red Clay	8	16
Blue Clay	16	22
Sand white	22	28
Blue Clay	28	80
Sand	80	105

WELL LOCATION:

sec. 30 T. 5 N. R. 11 E
2 miles SW of Ruston
(distance) (direction) (nearest town)

WELL PURPOSE:

Home
(home, irrigation, municipal, industrial)

WELL COMPLETION DATA:

- (1) diameter (inches) 2
- (2) total depth (feet) 105
- (3) static water level (feet) 65 (below above top of ground)
- (4) casing PVC, 100 (material) (depth)
(size) If telescope see back.
- (5) screen 5, 100 (length) (depth to top)
2, PVC (size) (material)
- (6) pump 1, 6 1/2 (HP) (yield gpm)
Elec (type power)
- (7) electric log No (yes or no)
(organization running log)
- (8) how well bottom plugged Valve

CODED

MAR 6 - 1970


MISS. Bd. OF WATER COMMISSIONERS

DRILLERS REMARKS:

Ormet Cochran

If well telescopes please sketch and show depths.

GROUND LEVEL

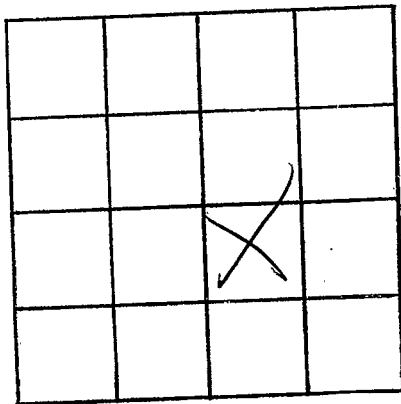

SECTION 30

Please indicate well location X.

ADDITIONAL INFORMATION

If more than one screen, show locations of each on sketch.